


T.3S.R.IW.W.M.

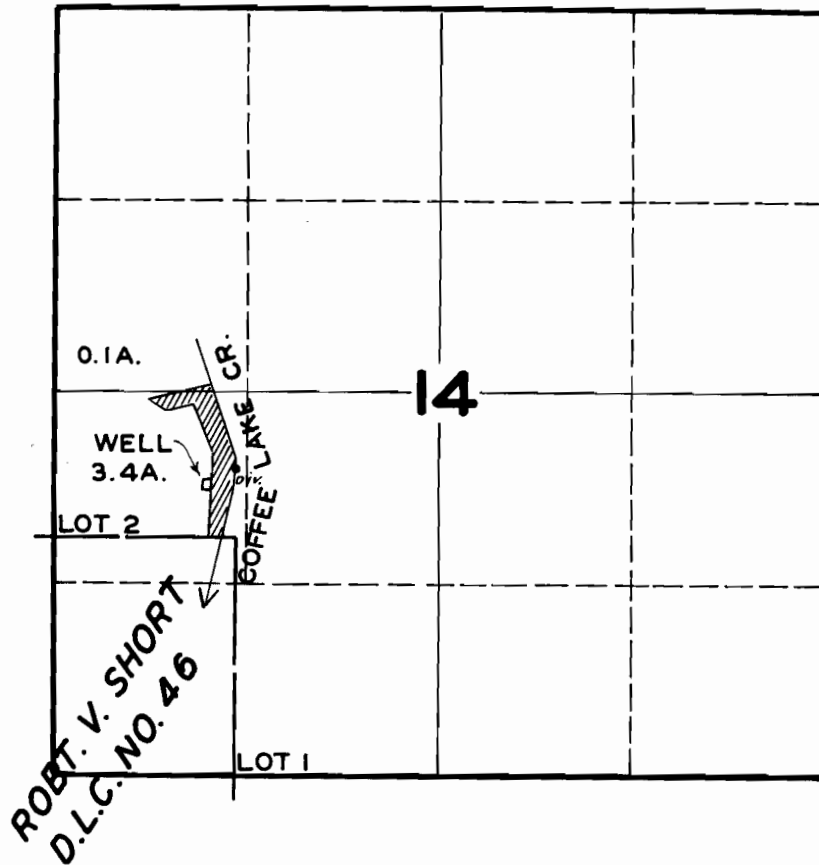

FINAL PROOF SURVEY

UNDER

Application No. **20241** Permit No. **15782**

IN NAME OF

OTTO JAEGER

Surveyed **JUNE 7 1948**, by **JAS. E. BUNNELL**