


T.2S.R.1W.W.M.

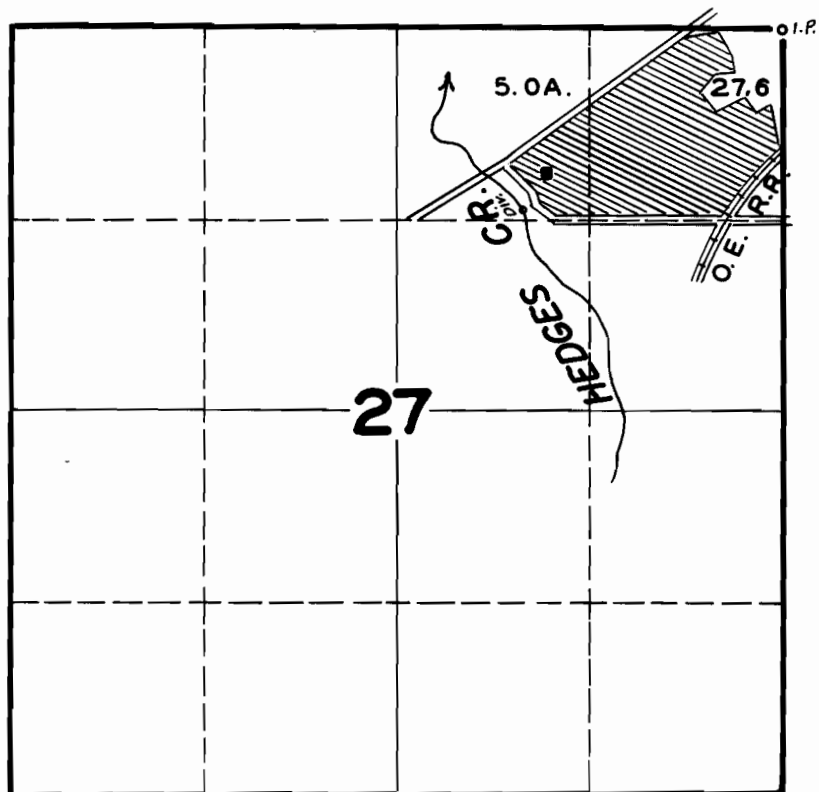

FINAL PROOF SURVEY
UNDER

Application No. **20272** Permit No. **15800**

IN NAME OF

LEO ELWERT

Surveyed **MAY 4** 1948, by **JAS. E. BUNNELL**