


T.11&12S. R.2W.W.M.

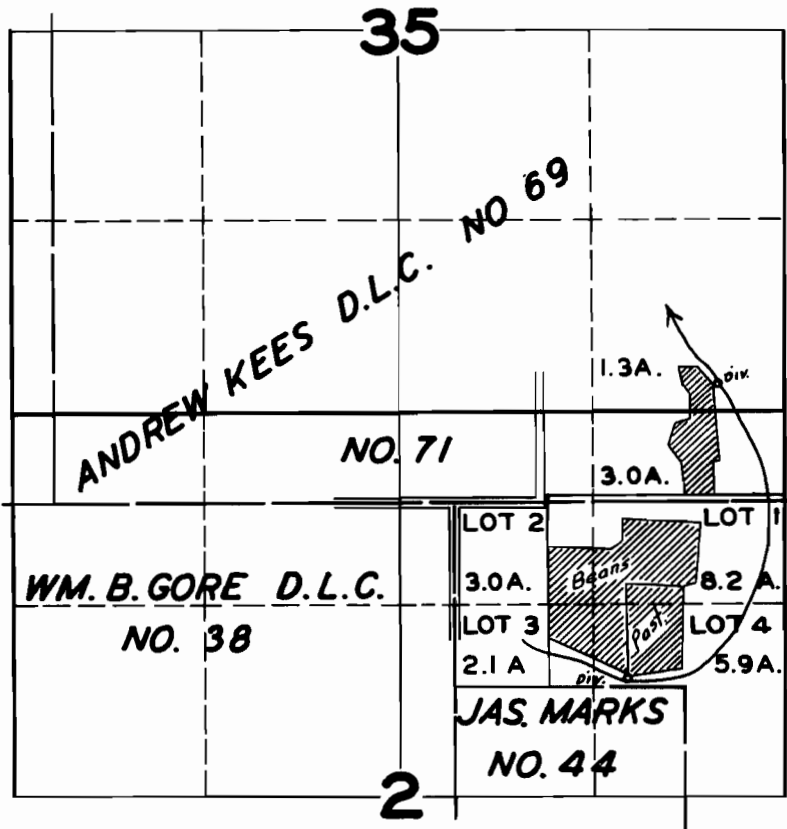

**FINAL PROOF SURVEY**  
UNDER

Application No. 20183 Permit No. 15802

IN NAME OF

E. R. LIGGETT

Surveyed OCT. 24 1947, by JAS. E. BUNNELL