


T.6S. R. 1W.W.M.

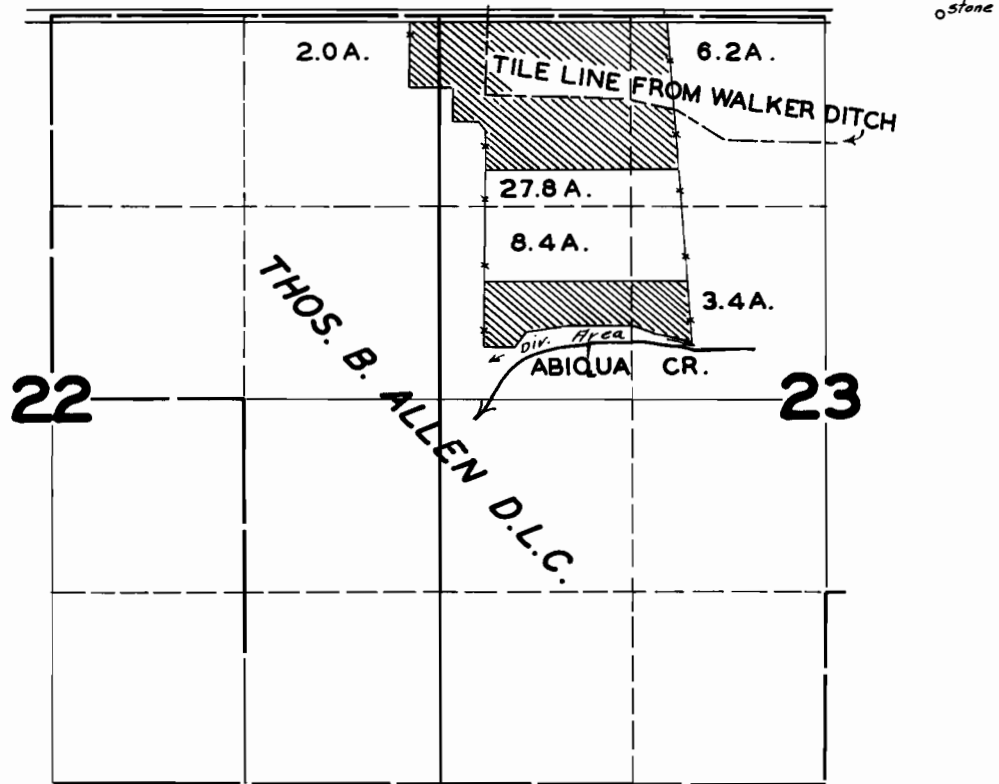

FINAL PROOF SURVEY UNDER

Application No. 20338 Permit No. 15866

IN NAME OF
ALBERT DIEHL

Surveyed OCT. 3, 1947, by JAS. E. BUNNELL