


**T.9S.R.4E.W.M.**

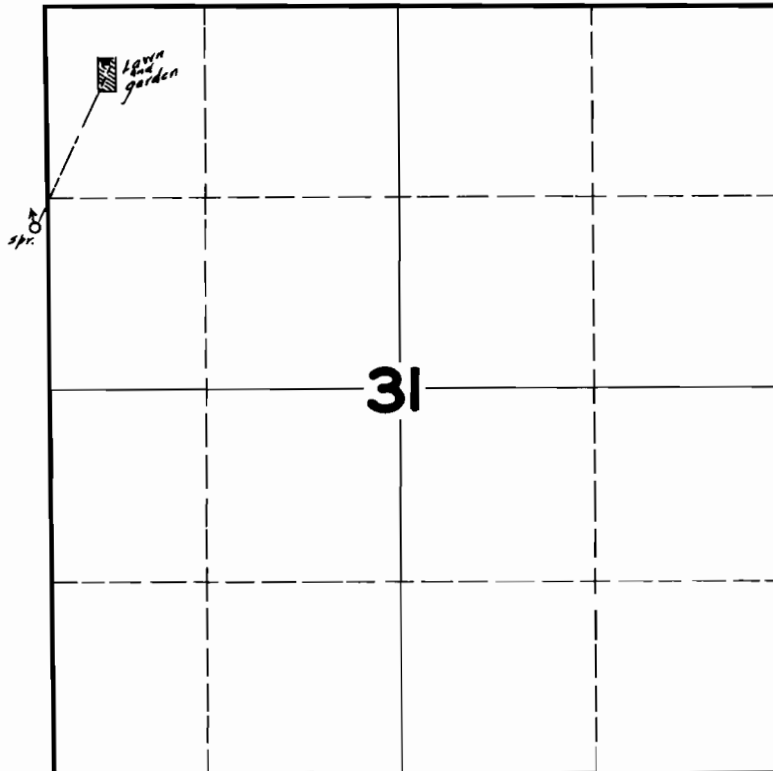

**FINAL PROOF SURVEY  
UNDER**

**Application No. 20372 Permit No. 15889**

**IN NAME OF**

**C. D. JOHNSON**

**Surveyed APR. 6 1946, by** *[Signature]*