


T.5S.R.1W.W.M.

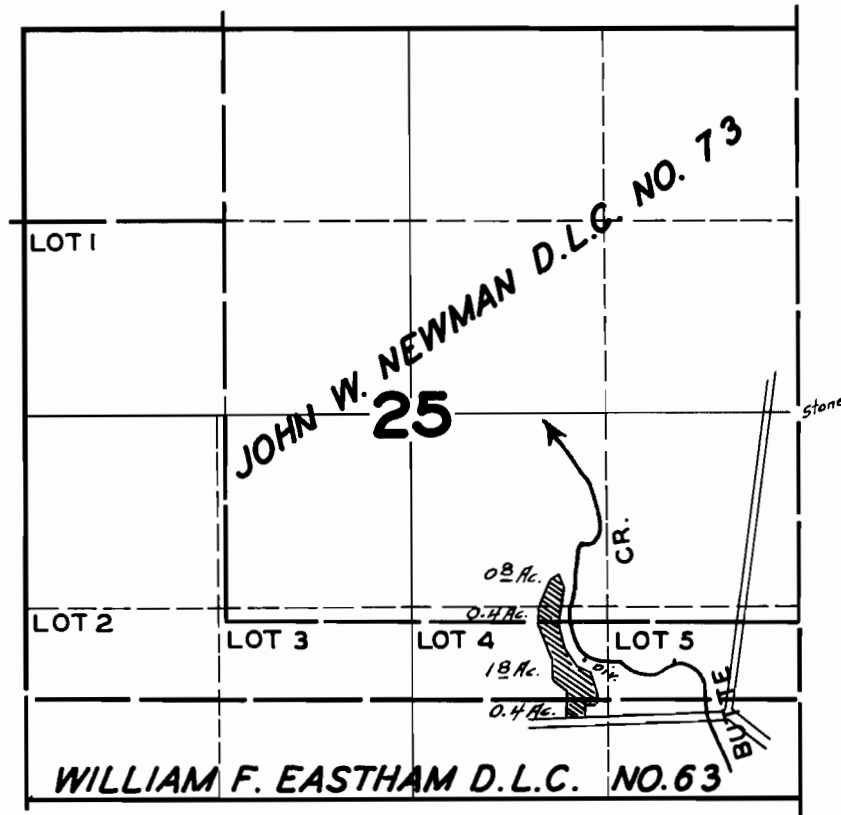

FINAL PROOF SURVEY UNDER

Application No. 20234 Permit No. 15924

IN NAME OF

L. C. SERGEANT

Surveyed OCT. 1, 1947, by JAS. E. BUNNELL