


T.1S.R.4W.W.M.

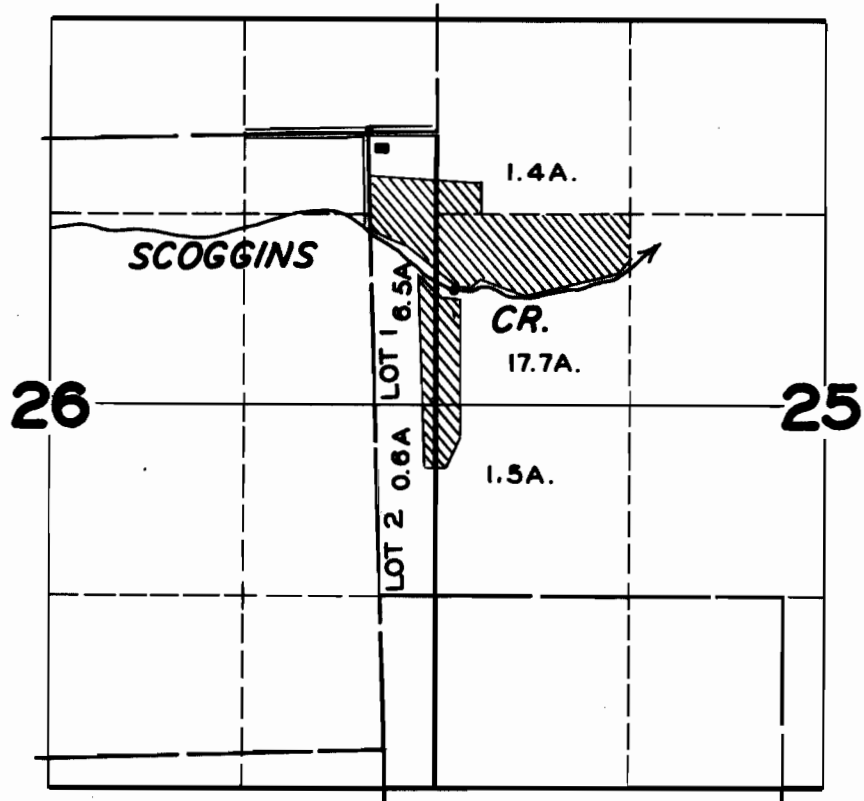

FINAL PROOF SURVEY
UNDER

Application No. 20440 Permit No. 15960
IN NAME OF

GEORGE C. BATALGIA

Surveyed MAY 19 1948, by JAS. E. BUNNELL