


T.8S.R.6W.W.M.

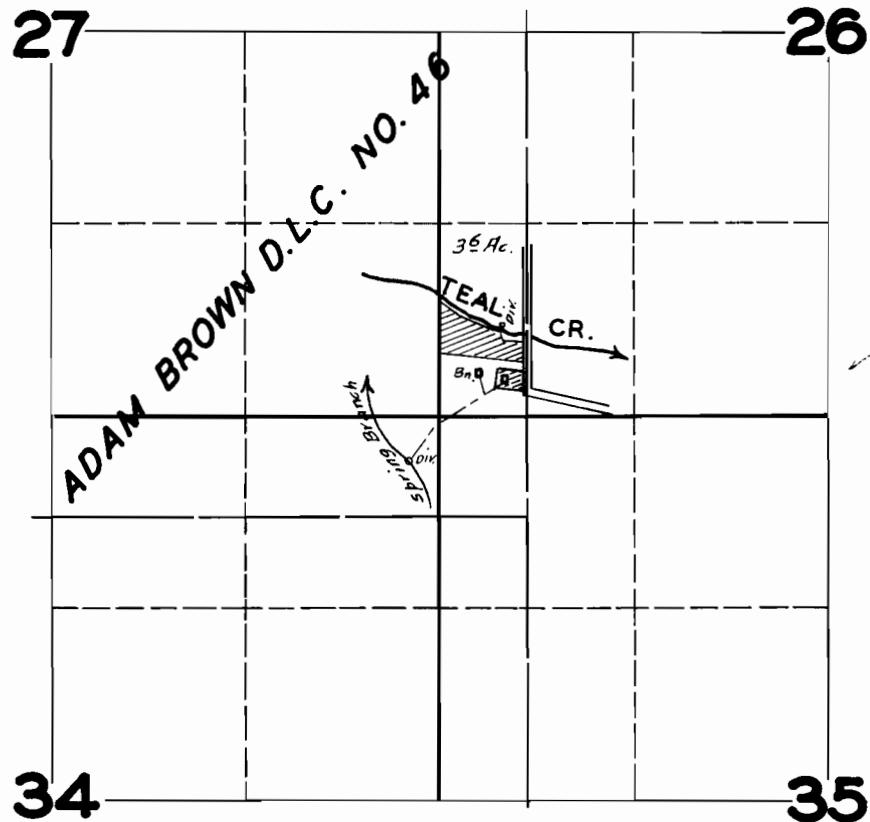

FINAL PROOF SURVEY UNDER

Application No. 20461 Permit No. 15975
IN NAME OF

CARL BARNARD

Surveyed MAR. 15, 1947, by JAS. E. BUNNELL