


T.5S.R.1W.W.M.

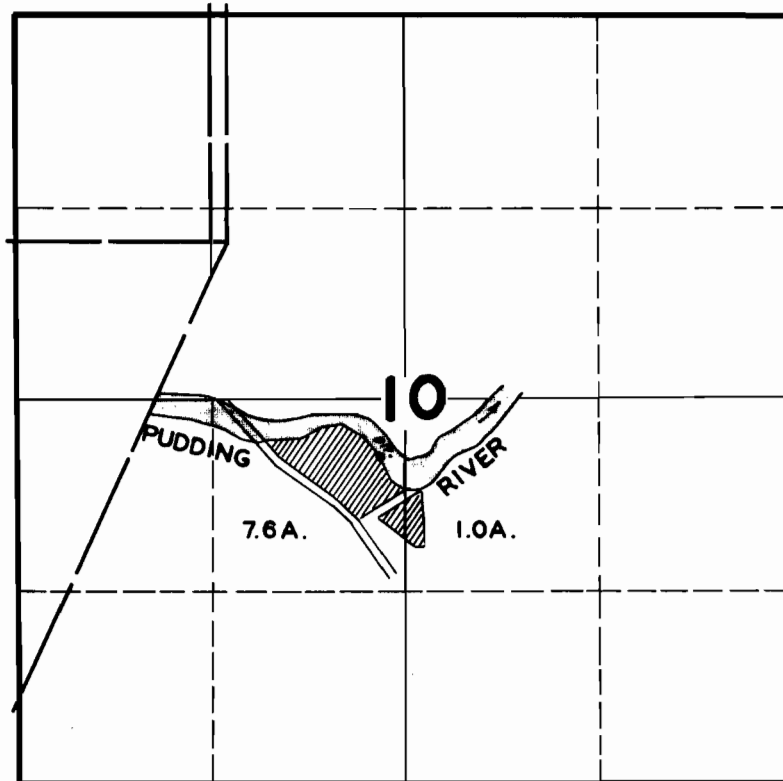

FINAL PROOF SURVEY UNDER

Application No. 20532 Permit No. 16032

IN NAME OF
H. C. STUWE

Surveyed OCT. 1, 1947, by JAS. E. BUNNELL