


T.13S.R.6W.W.M.

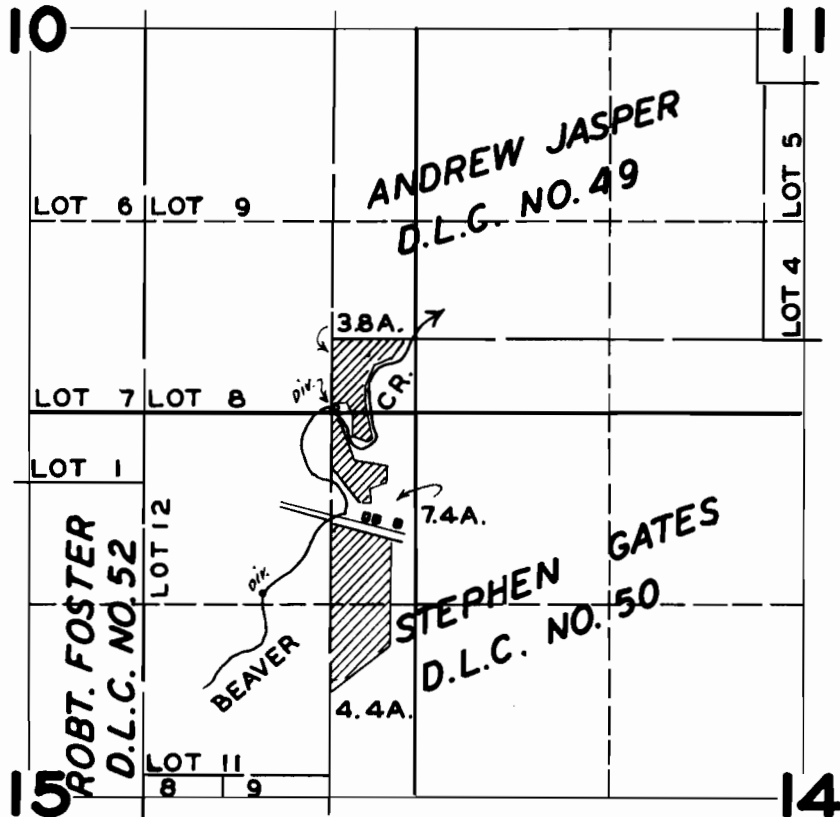

**FINAL PROOF SURVEY**  
UNDER

Application No. **20536** .. Permit No. **16035** ..  
IN NAME OF

..... **JOHN R. SAXTON** .....

Surveyed **JUNE 25 1948**, by **JAS. E. BUNNELL**