


T.13S.R.6W.W.M.

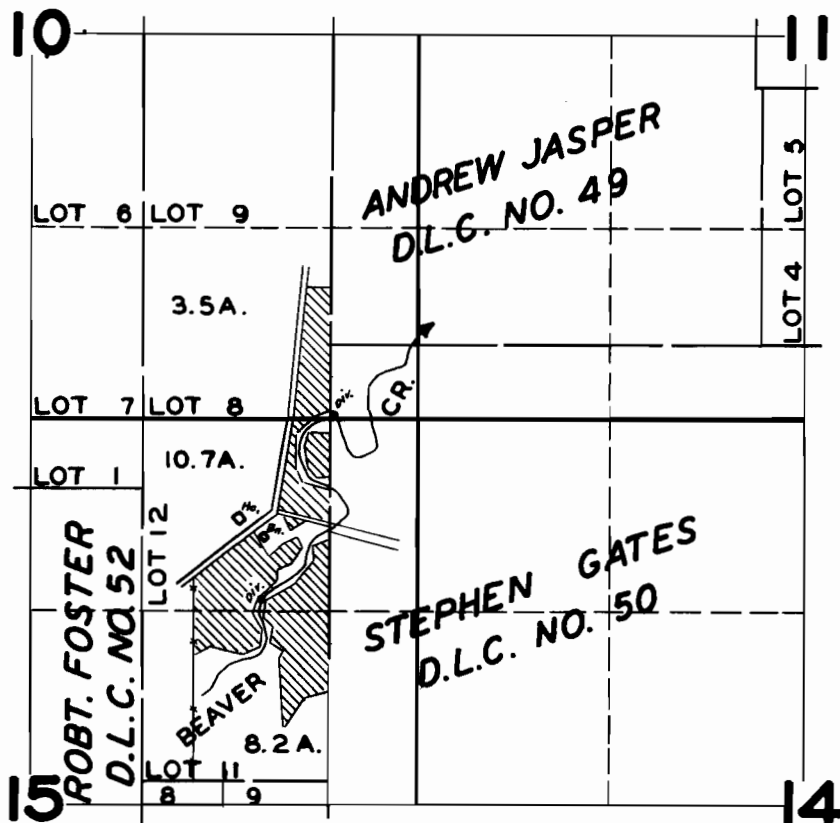

FINAL PROOF SURVEY
UNDER

Application No. **20537** Permit No. **16036**
IN NAME OF

E. B. CARLIN

Surveyed **JUNE 25 1948**, by **JAS. E. BUNNELL**