


**T. 7S. R. 3W. W.M.**

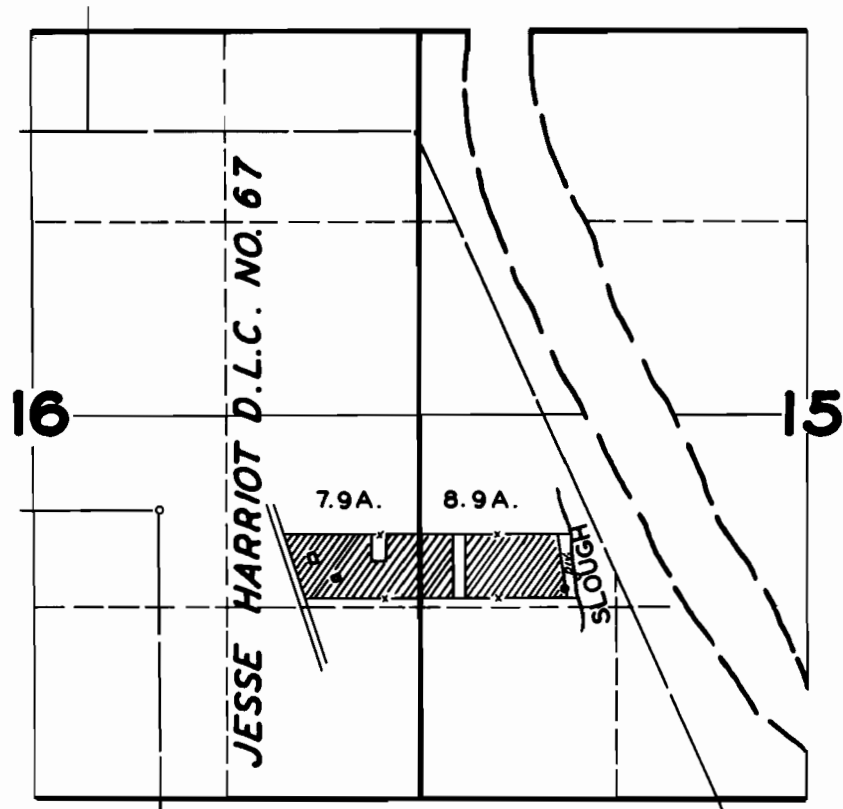

**FINAL PROOF SURVEY**  
UNDER

Application No. **20550** Permit No. **16042**  
IN NAME OF

**REX GIBSON**

Surveyed **SEP. 17, 1947**, by **JAS. E. BUNNELL**