


15			14			13			
22			23			24			
27			26			25			
34			35			36			

FROM OFFICE OF THE STATE ENGINEER, SALEM, OREGON

Willow Creek Adjudication.


35.28 E.

Township 3. S. ,

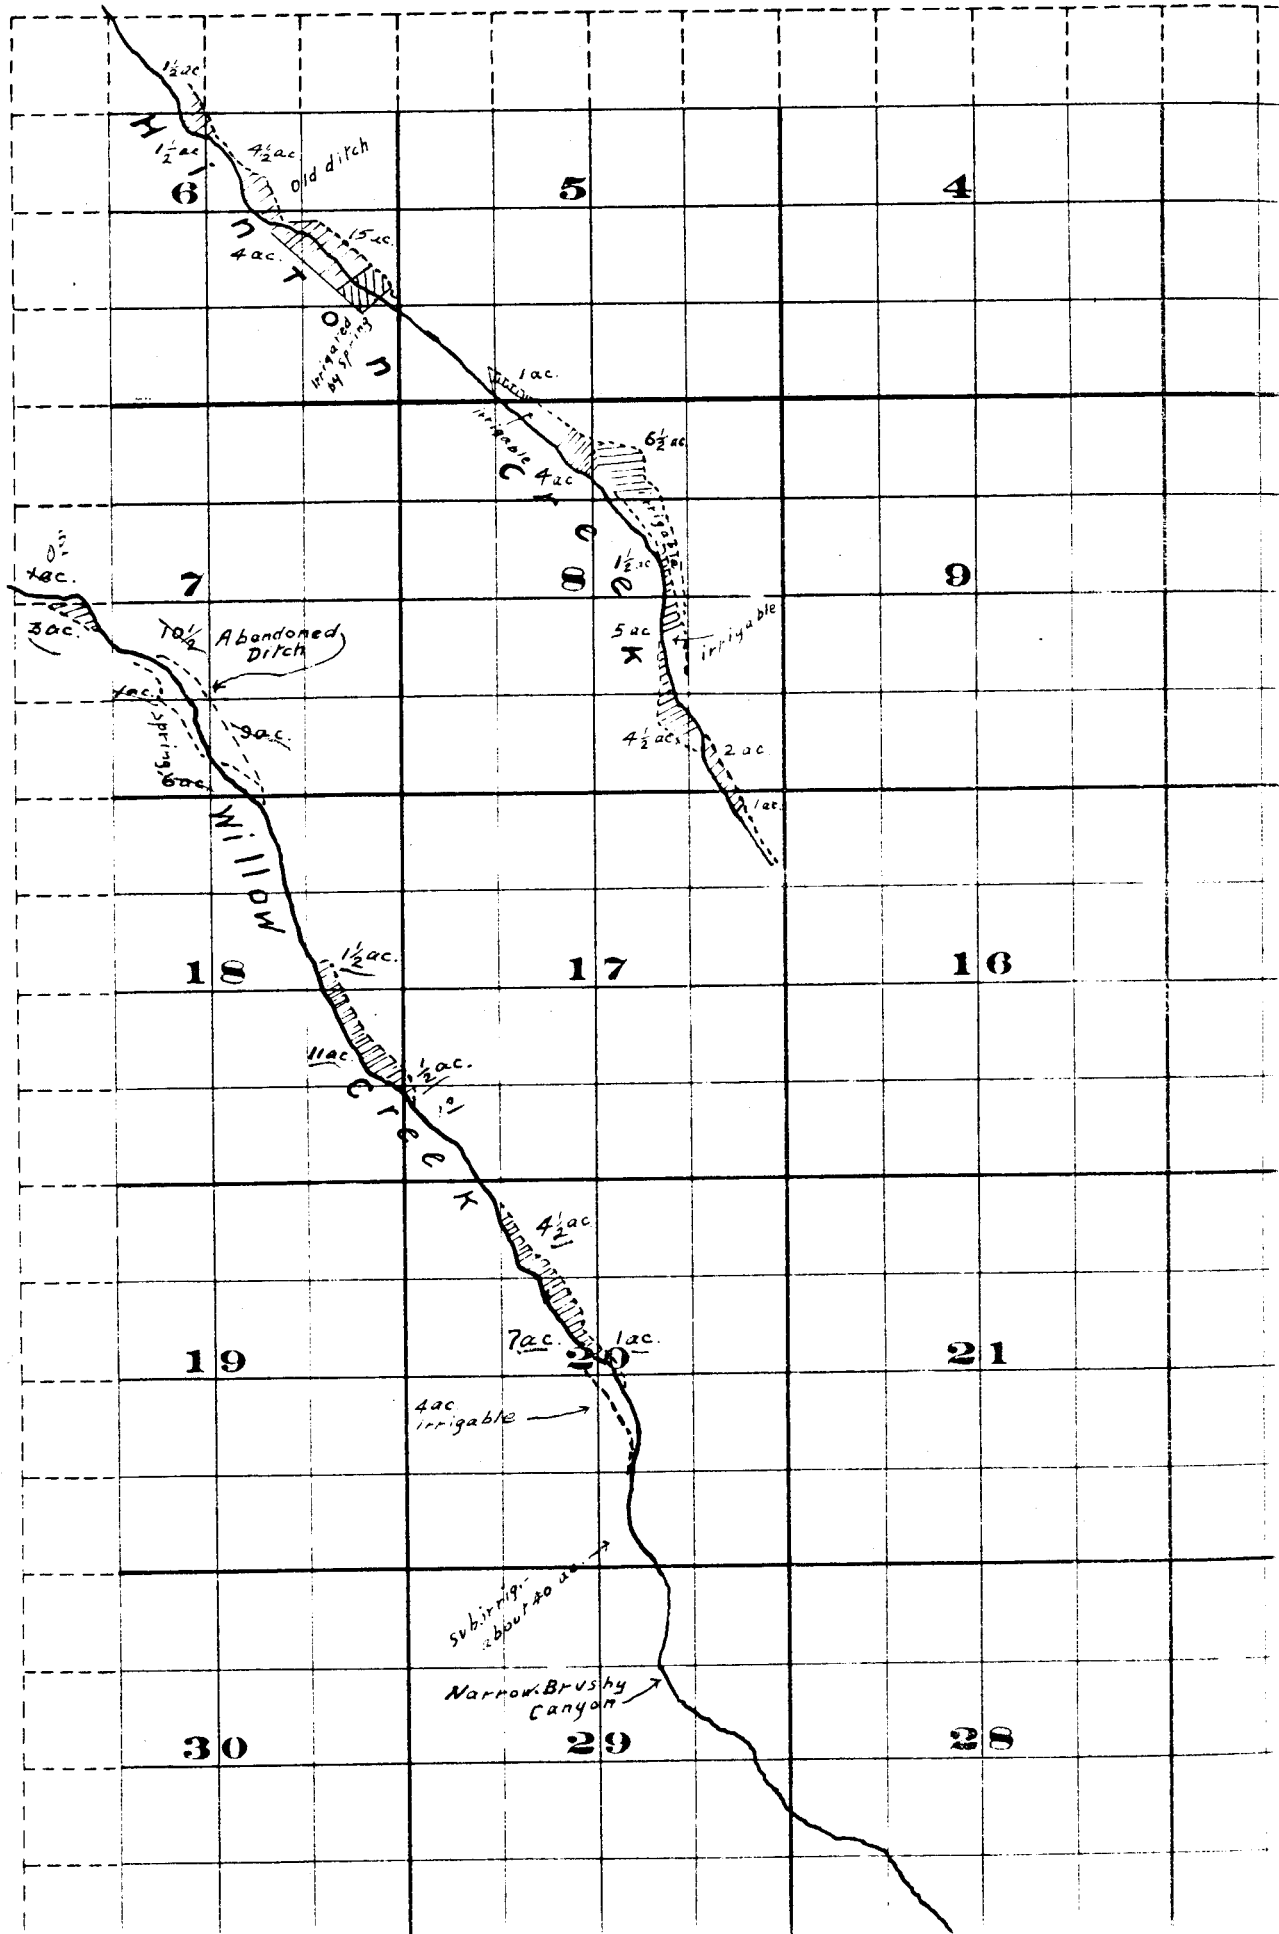


S. , Range

[illegible]

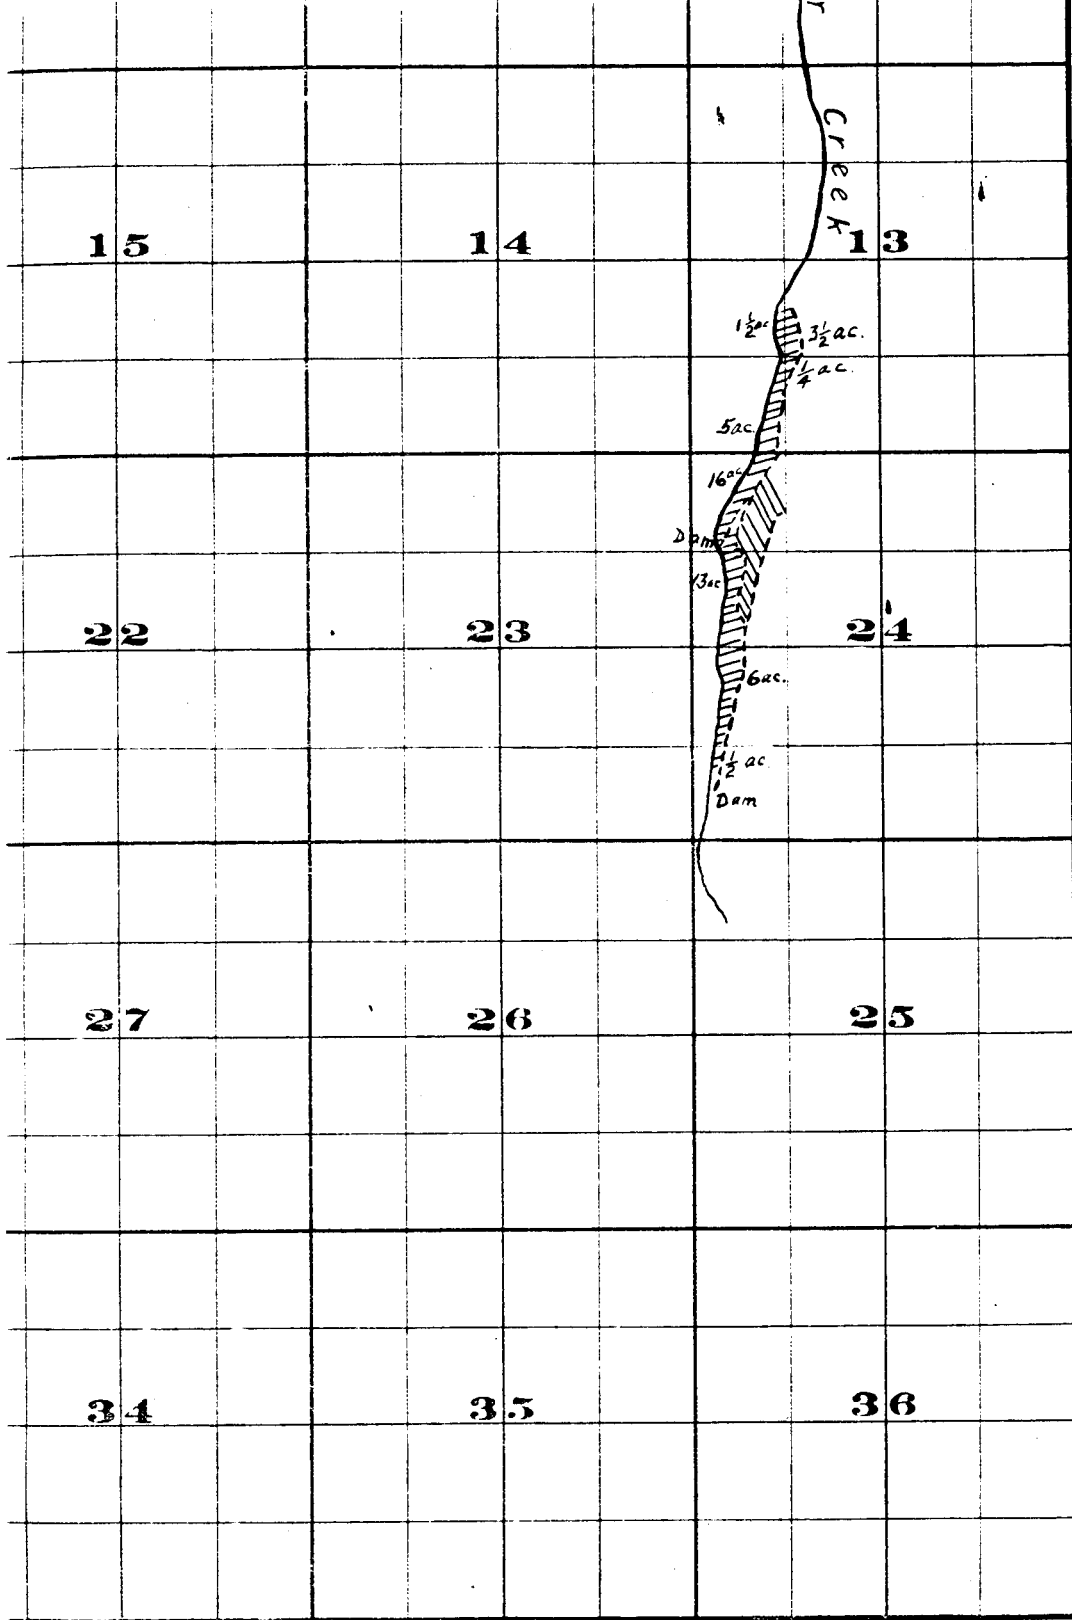

FROM OFFICE OF THE STATE ENGINEER, SALEM, OREGON
Willow Creek Adjudication

35.27 E.

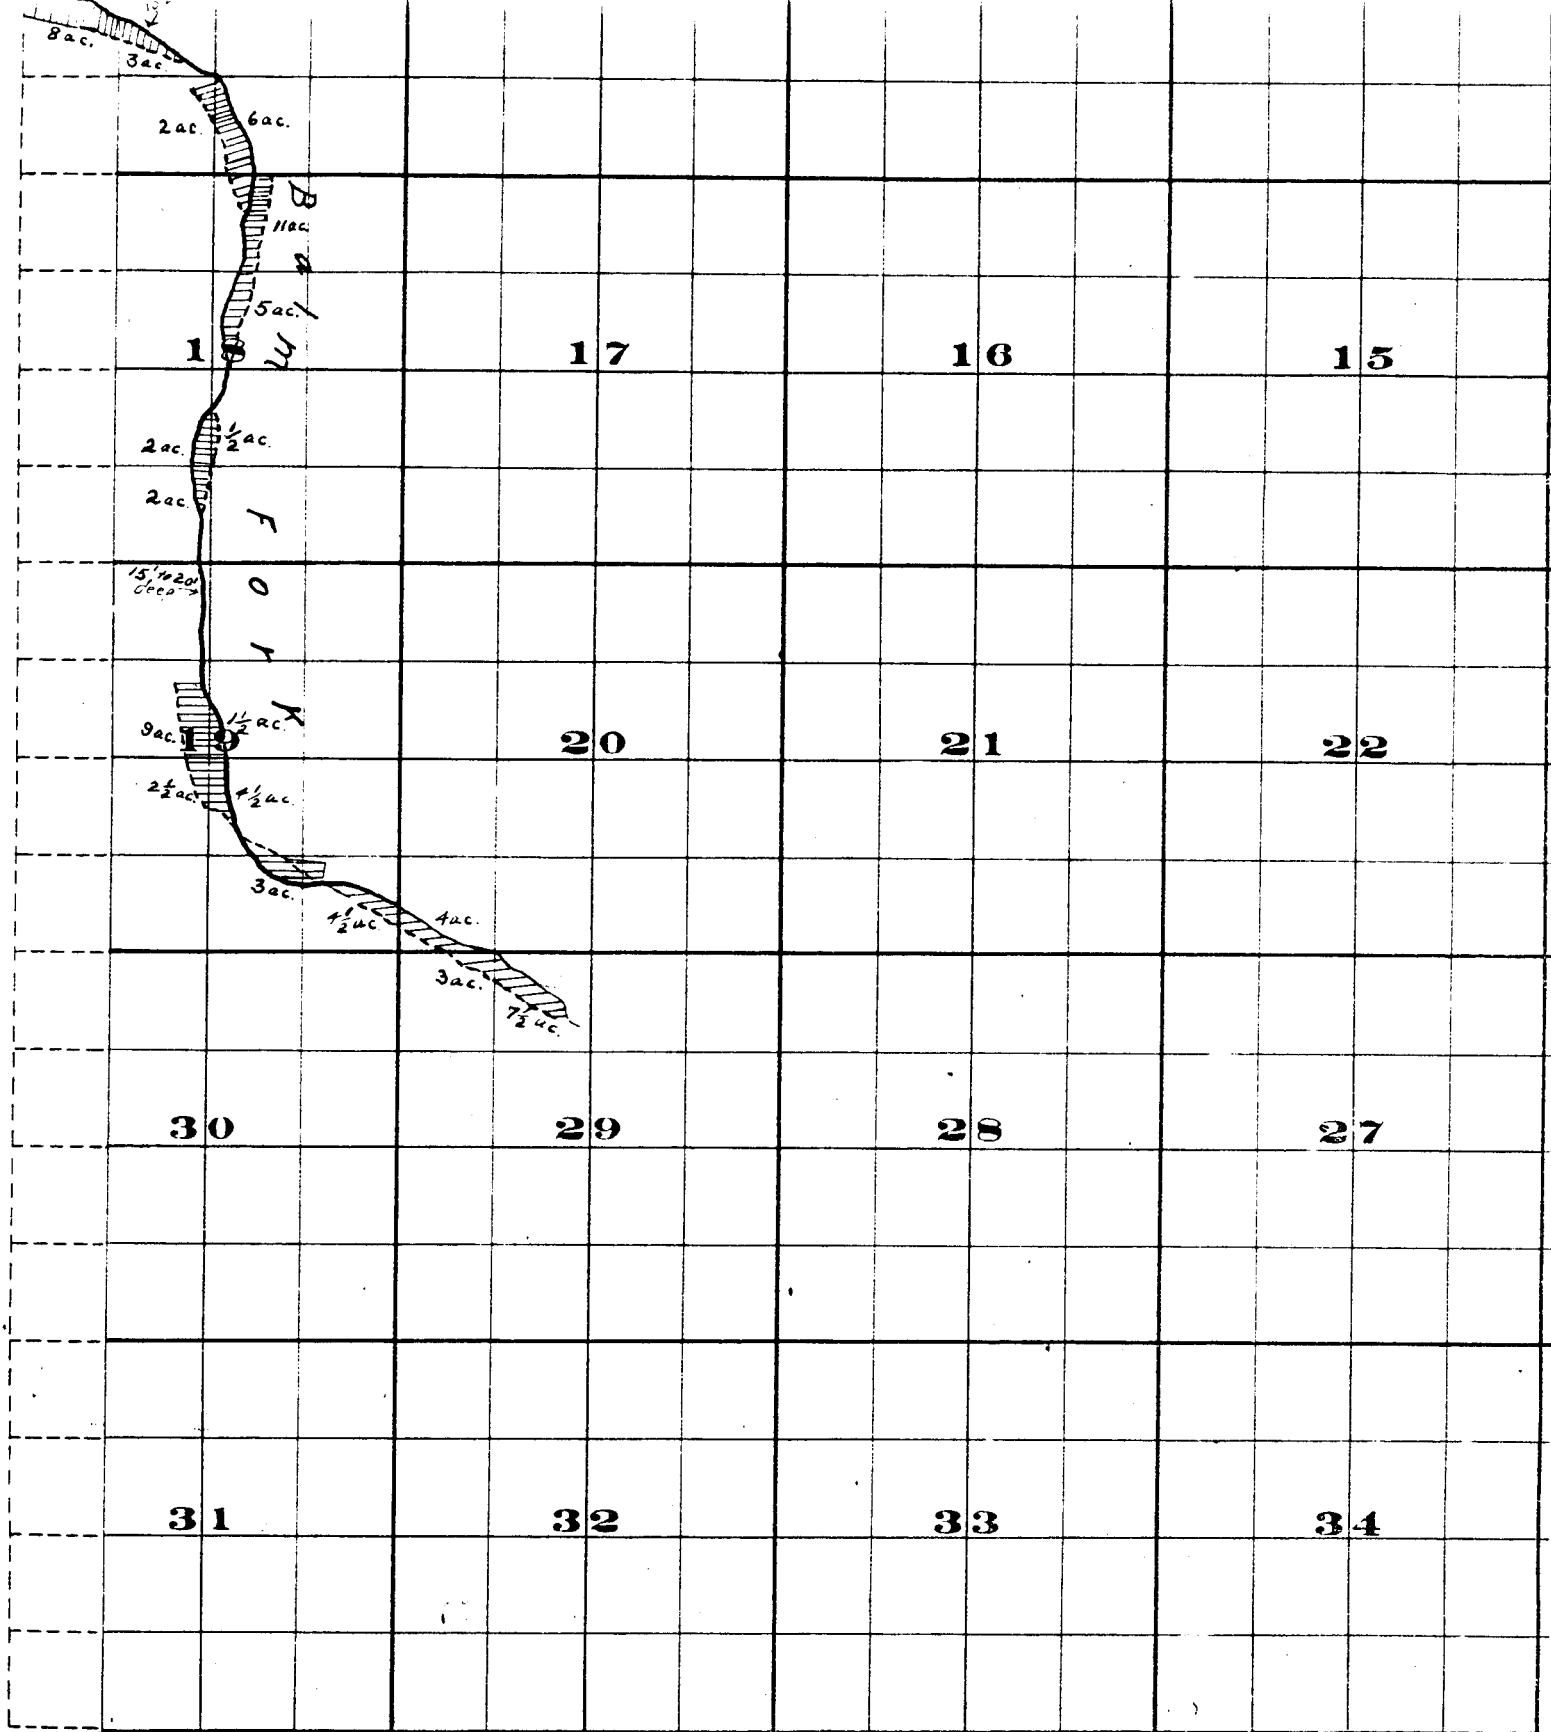


THE S. A. BRISTOL CO. PRINTERS & BOOKBINDERS CHICAGO, ILL.

Surveyed by H. K. Donnelly July 1909
 Surveyed by R. D. Cooper July 1909
 John H. Lewis - State Engineer
 Examined, July 14, 1909.

Township 35

,

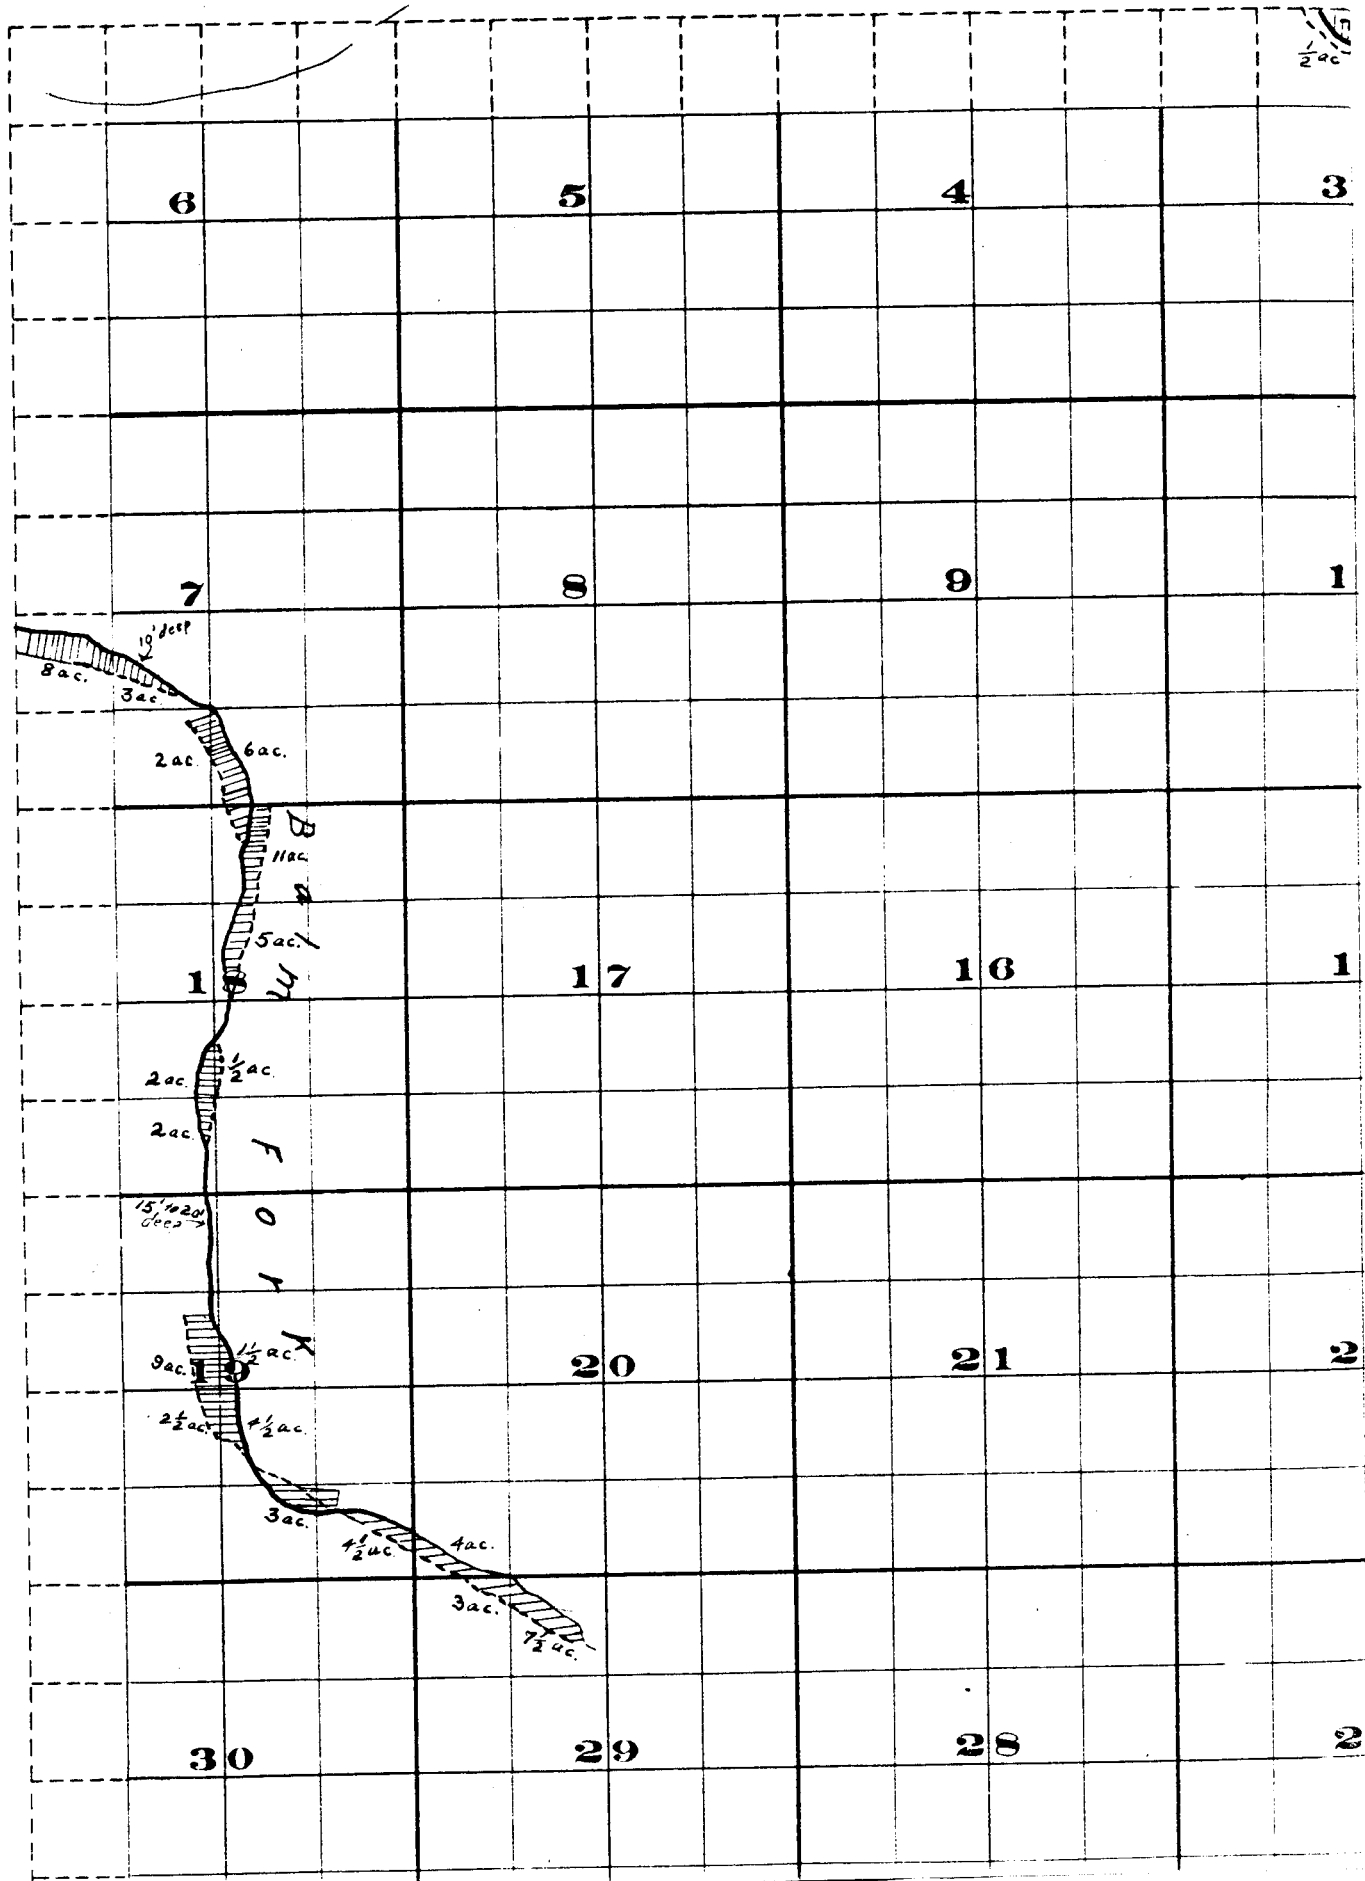

, Range 27 E.W.M..

