


T. 1S. R. 4W. W.M.

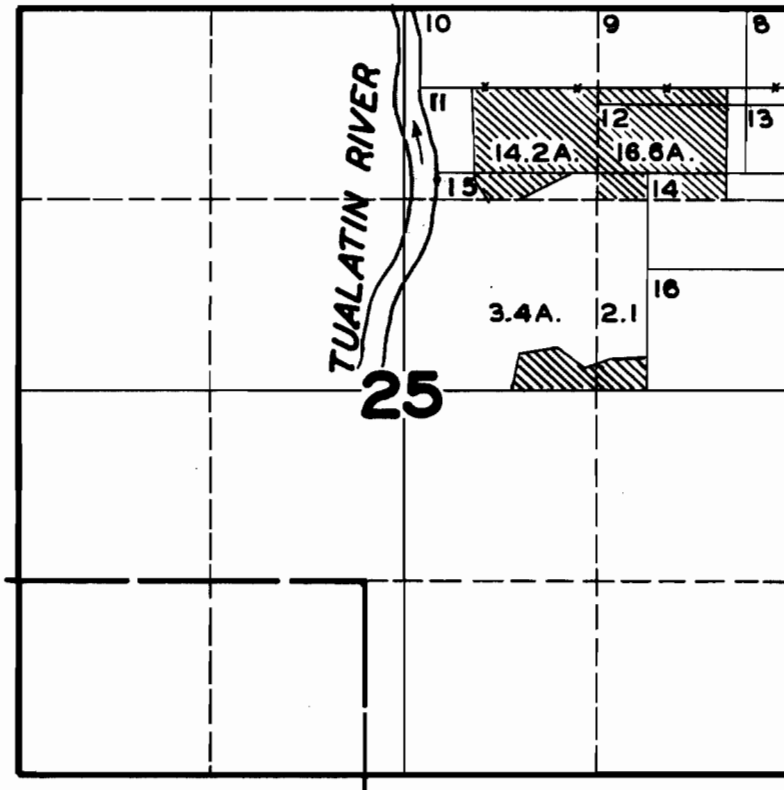

FINAL PROOF SURVEY UNDER

Application No. 20607 Permit No. 16100
IN NAME OF

C. B. BUCHANAN, JR.

Surveyed MAY 18 1948, by JAS. E. BUNNELL