


T.6S.R.1W.W.M.

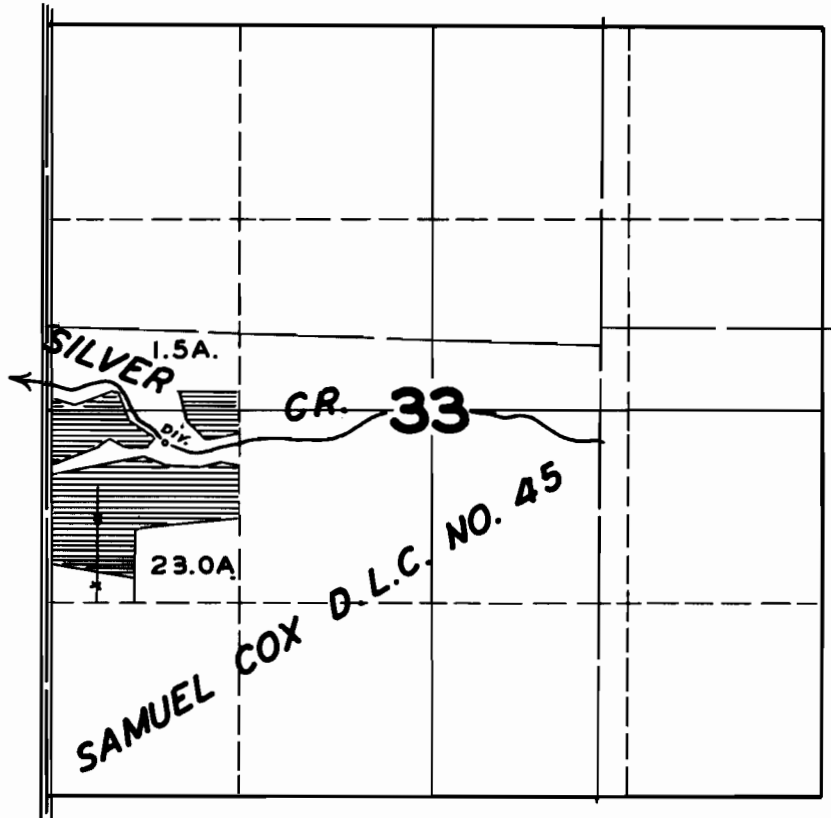

FINAL PROOF SURVEY

UNDER

Application No. **20619**... Permit No. **16130**....

IN NAME OF

MISS MERLE BOWEN

Surveyed **APR. 13 1949**, by **JAS. E. BUNNELL**