


# T.4S.R.10W.W.M.

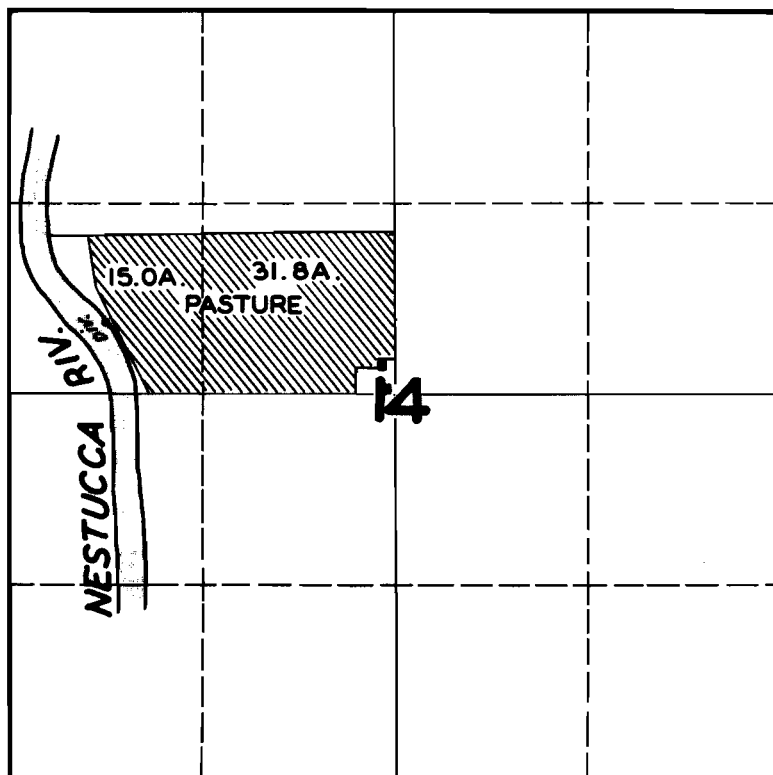

## FINAL PROOF SURVEY UNDER

Application No. **20636** Permit No. **16141**  
IN NAME OF

**ED. GROSSEN**

Surveyed **SEP. 1** 1948, by **JAS. E. BUNNELL**