


# T.4&5S.R.3W.W.M.

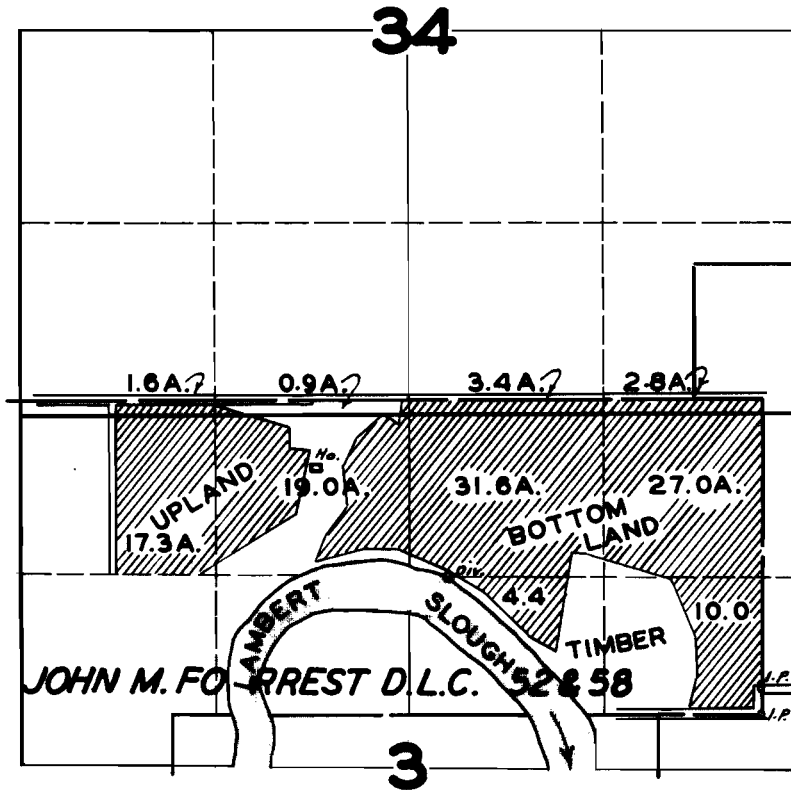

## FINAL PROOF SURVEY

UNDER

Application No. 20658 Permit No. 16159

IN NAME OF

JESSIE E. THOMAS

Surveyed MAR. 20 1947, by JAS E. BUNNELL