


T.27S.R.6W.W.M.

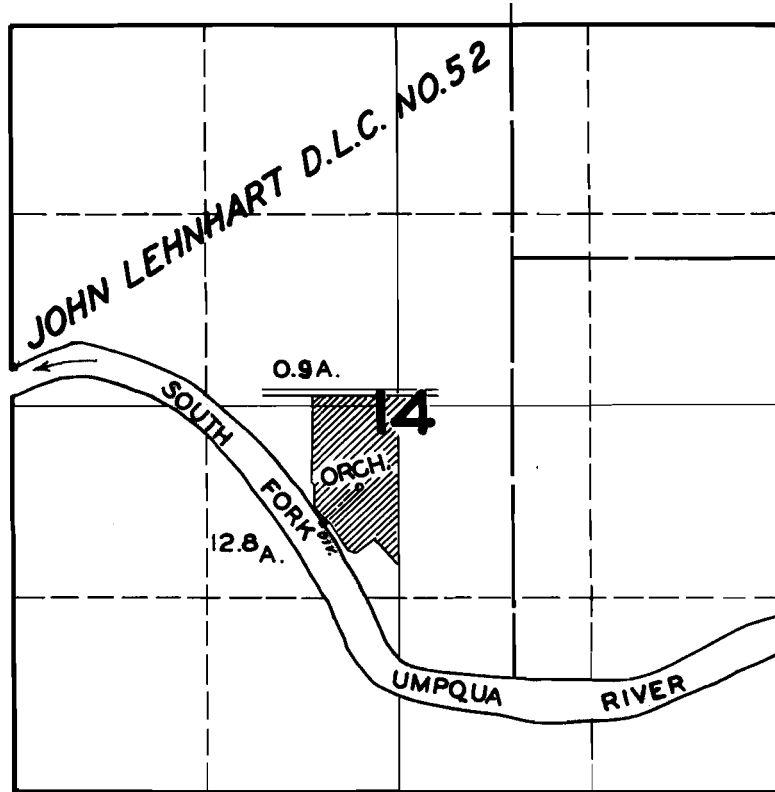

**FINAL PROOF SURVEY
UNDER**

Application No. 20689 Permit No. 16185

IN NAME OF

W. HAYDEN FISK

Surveyed JULY 11, 1947, by JAS. E. BUNNELL