


T.6S.R.1W.W.M.

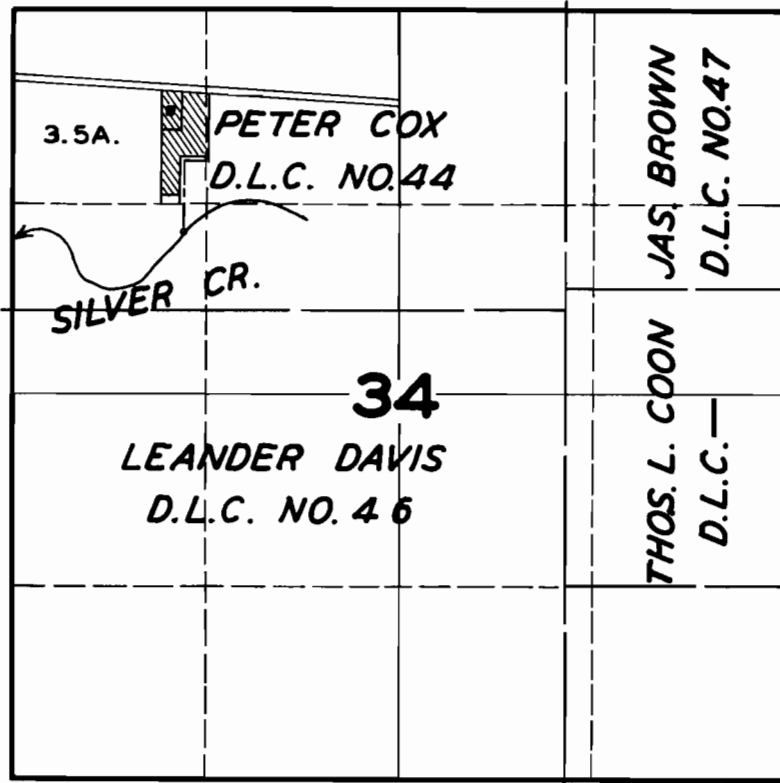

FINAL PROOF SURVEY

UNDER

Application No. 20706... Permit No. 16210.....

IN NAME OF

FRANK LANHAM, ERNEST W. LANHAM & HELEN GAY LANHAM

Surveyed MAR. 23 1948, by JAS. E. BUNNELL