


T.4 & 5S.R.1W.W.M.

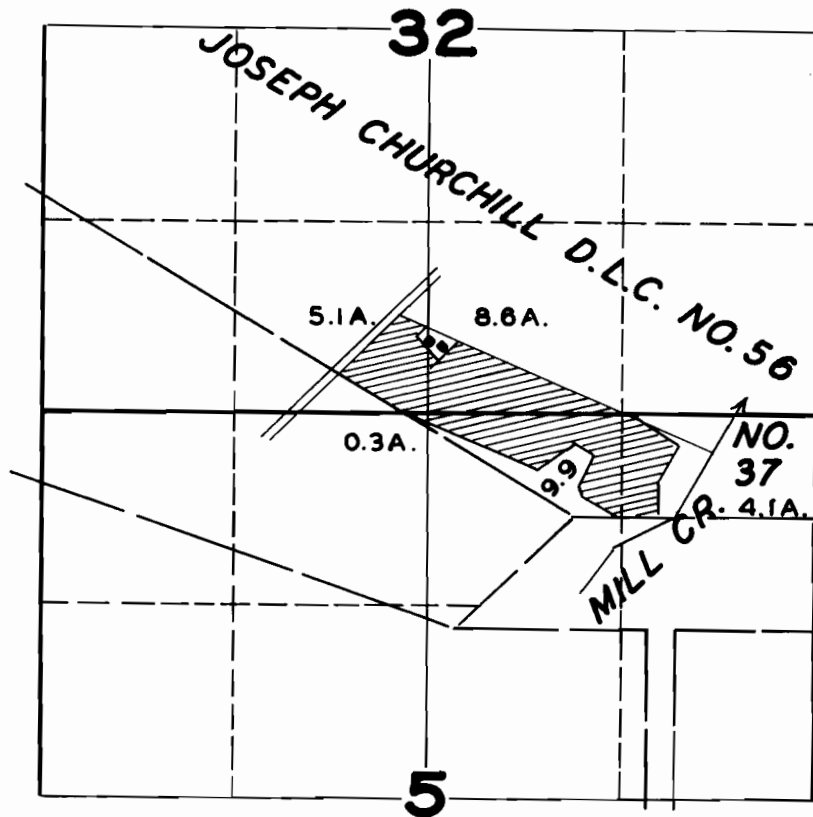

FINAL PROOF SURVEY

UNDER

Application No. 20747 Permit No. 16237

IN NAME OF

FLORENCE EVANS

Surveyed MAY 3 1949, by JAS. E. BUNNELL