


T.8S.R.6W.W.M.

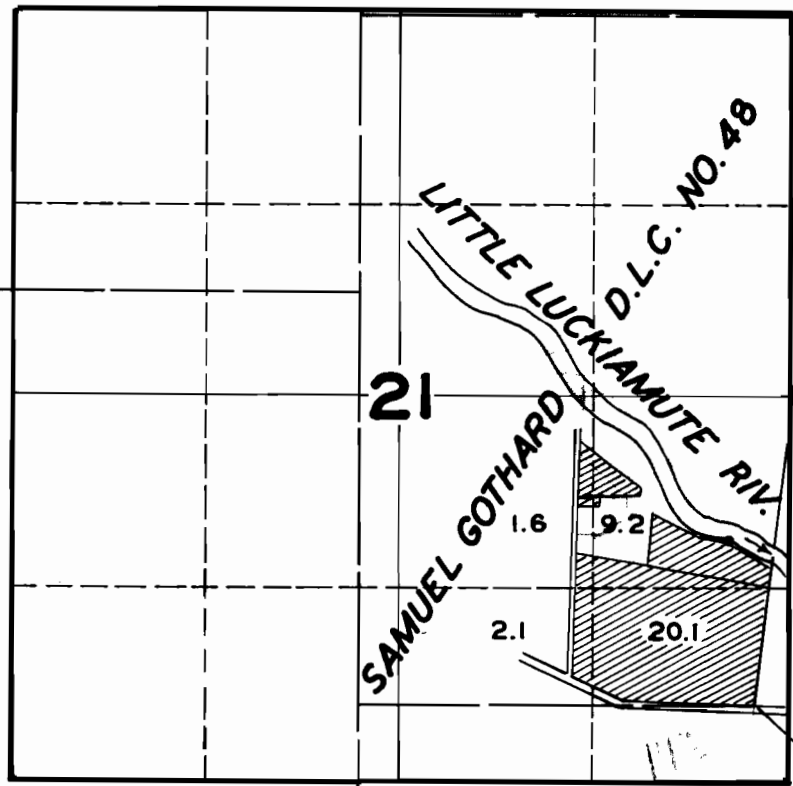

FINAL PROOF SURVEY UNDER

Application No. **20748**... Permit No. **16238**...
IN NAME OF

BIRCHELL H. & N. IRENE NELSON...

Surveyed **APR. 13, 1949**, by **JAS. E. BUNNELL**

24266
1949-2