


T.12S.R.5W.W.M.

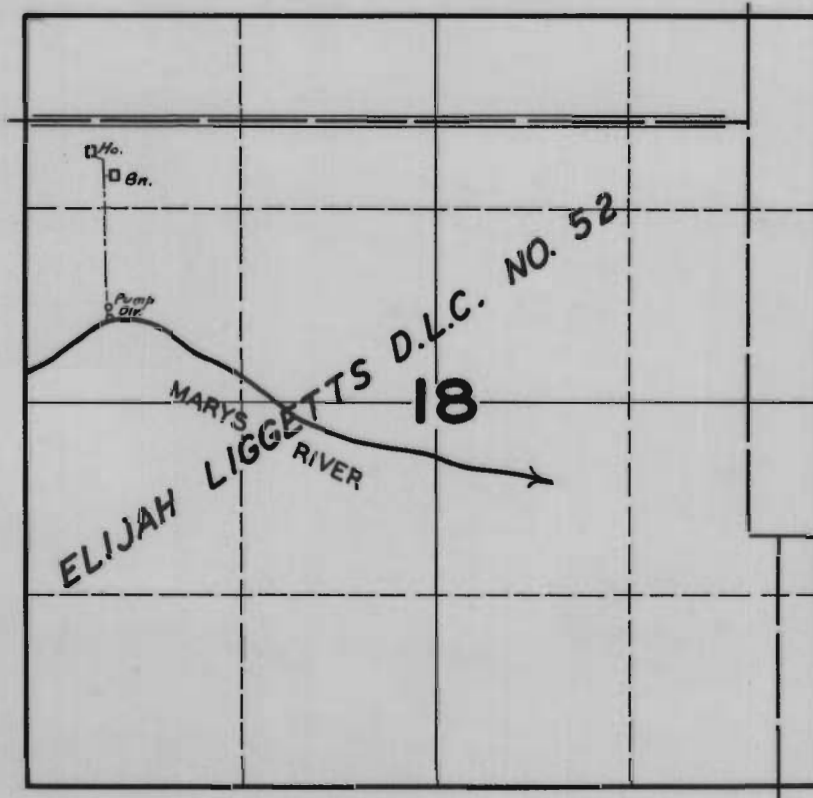

**FINAL PROOF SURVEY  
UNDER**

**Application No. 20819 Permit No. 16291**

**IN NAME OF**

**FRANK L. MERRILL**

**Surveyed AUG. 26 1947, by JAS. E. BUNNELL**