


T.11S.R.7W.W.M.

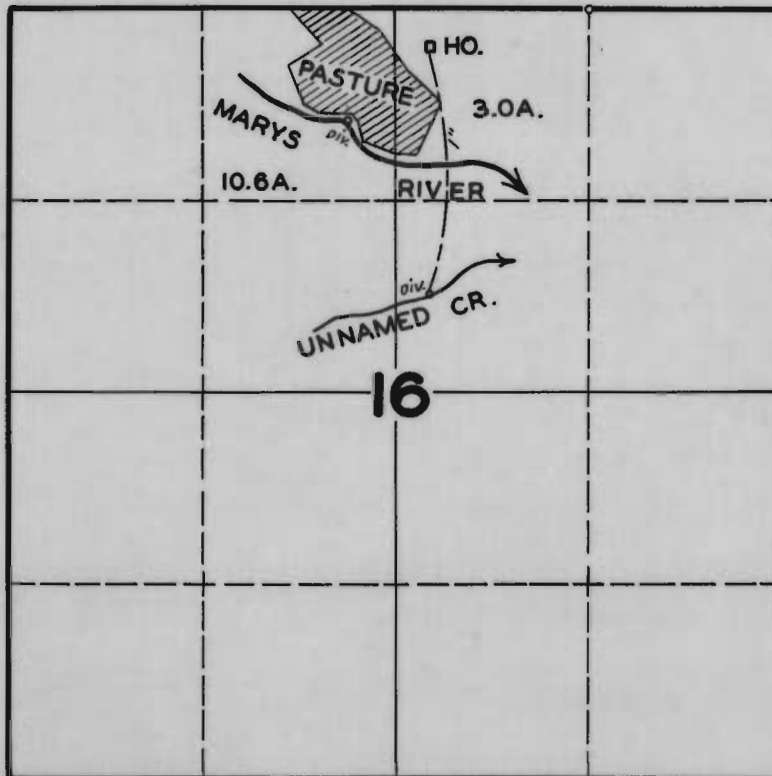

FINAL PROOF SURVEY
UNDER

Application No. 20824 Permit No. 16295
IN NAME OF

GROVER A. CLARK

Surveyed JULY 8 1948, by JAS. E. BUNNELL