


T.4S.R.4W.W.M.

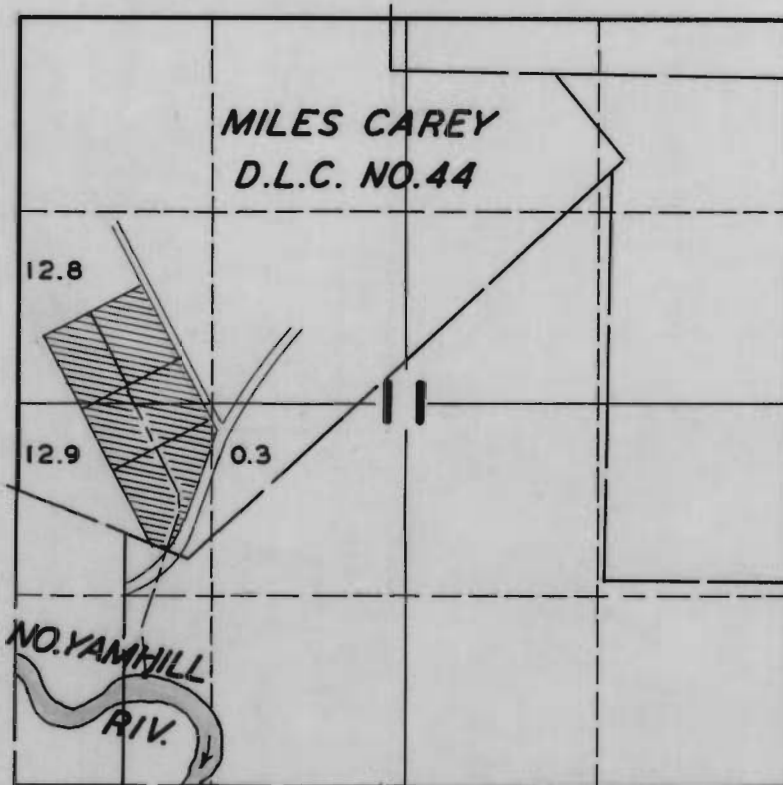

FINAL PROOF SURVEY

UNDER

Application No. **20863** Permit No. **16340**

IN NAME OF

A.G. ROBERTS

Surveyed **MAY 6** 1949, by **JAS. E. BUNNELL**