


T.4S.R.9&10W.W.M.

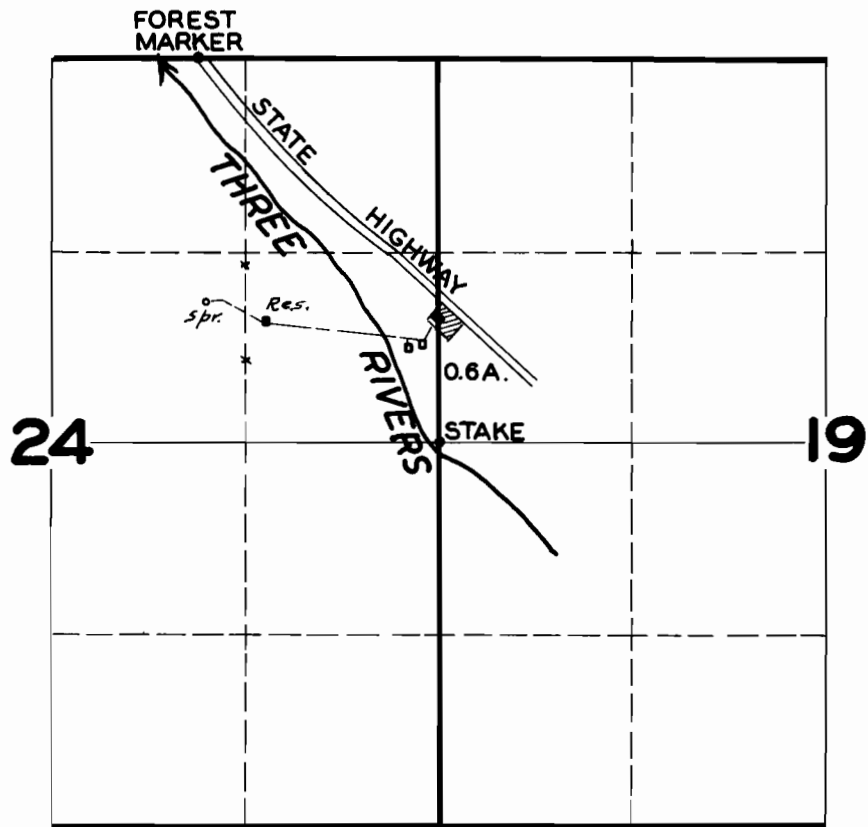

FINAL PROOF SURVEY UNDER

Application No. 20905 Permit No. 16372
IN NAME OF

FRANK WILSON

Surveyed SEP. 1 1948 by JAS. E. BUNNELL