


T.7S.R.IW.W.M.

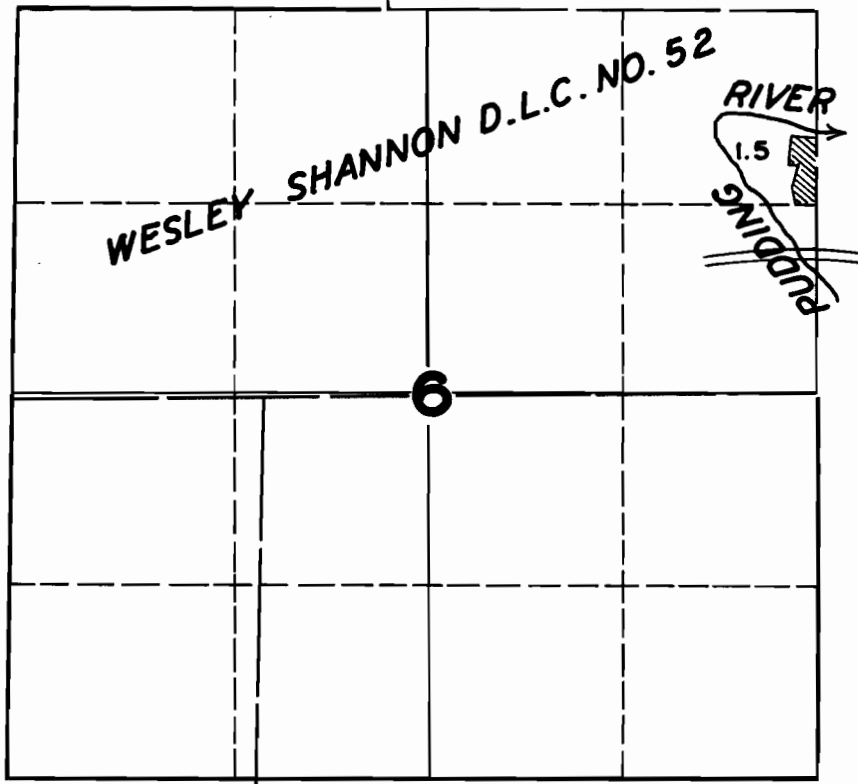

**FINAL PROOF SURVEY**

UNDER

Application No. **20987** Permit No. **16427**

IN NAME OF

**KARL DETTWYLER**

Surveyed **APR. 14 1949**, by **JAS. E. BUNNELL**