


T.6S.R.IW.W.M.

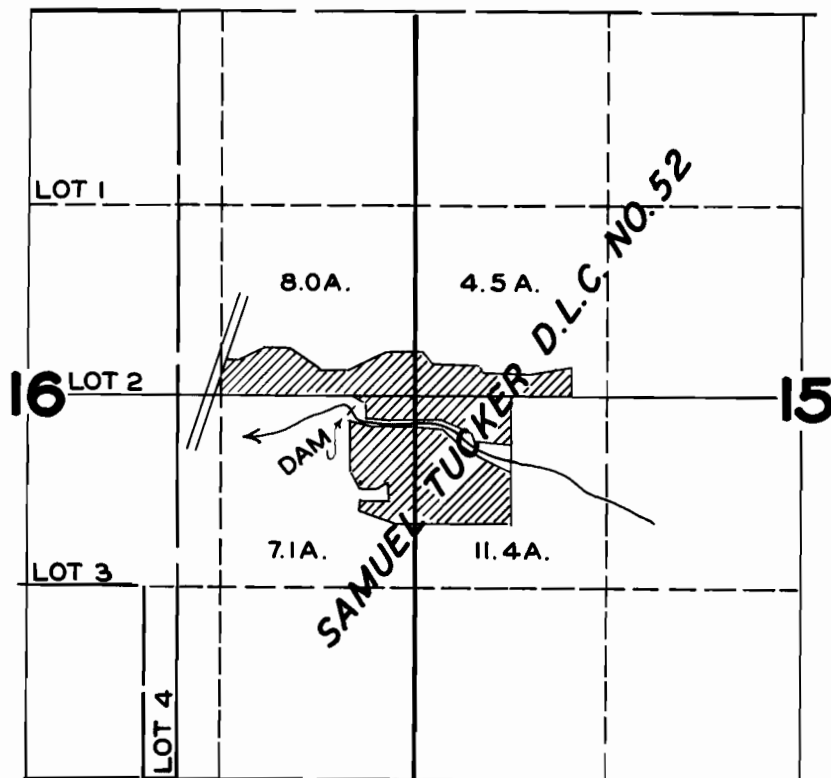

FINAL PROOF SURVEY UNDER

Application No. **20931** ... Permit No. **16466**
IN NAME OF

RAYMOND BUHR

Surveyed **SEP. 22 1948**, by **JAS. E. BUNNELL**