


**T.7S.R.4W.W.M.**

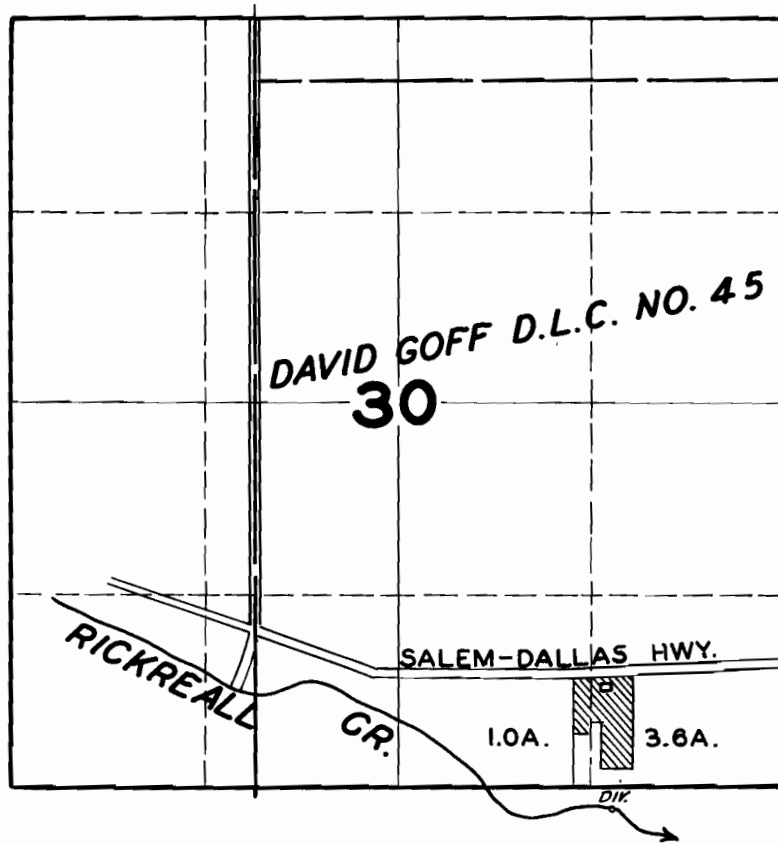

**FINAL PROOF SURVEY**  
UNDER

Application No. **21088** Permit No. **16526**  
IN NAME OF

**WILLIAM H. FERN**

Surveyed **MAR. 26 1948**, by **JAS. E. BUNNELL**