


# T.18S.R.8W.W.M.

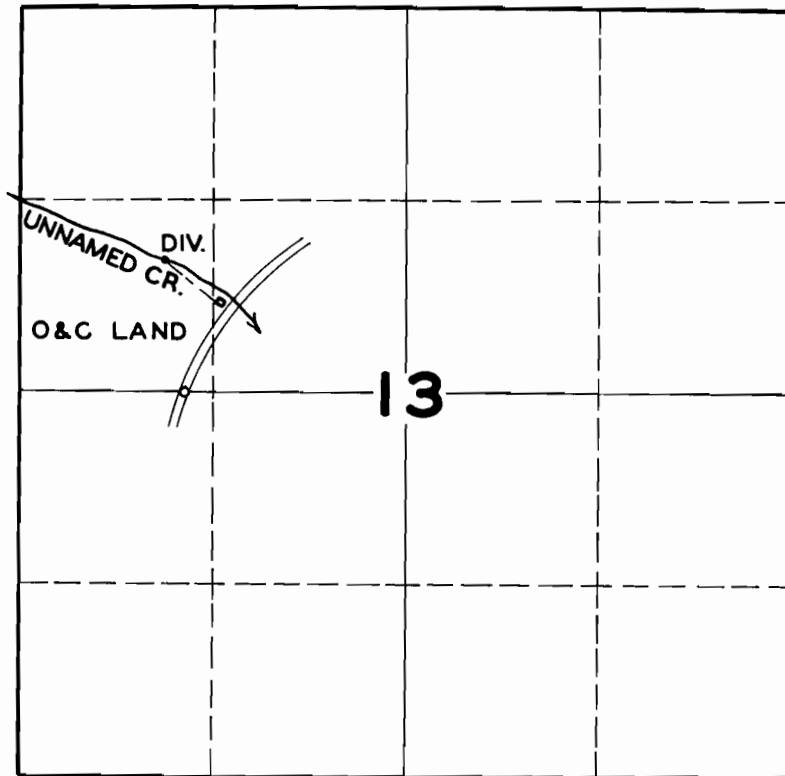

## FINAL PROOF SURVEY UNDER

Application No. **21092** Permit No. **16529**  
IN NAME OF

**LYALL KEITH**

Surveyed **JUL. 21. 1948**, by **JAS. E. BUNNELL**