


T.8S.R.IW.W.M.

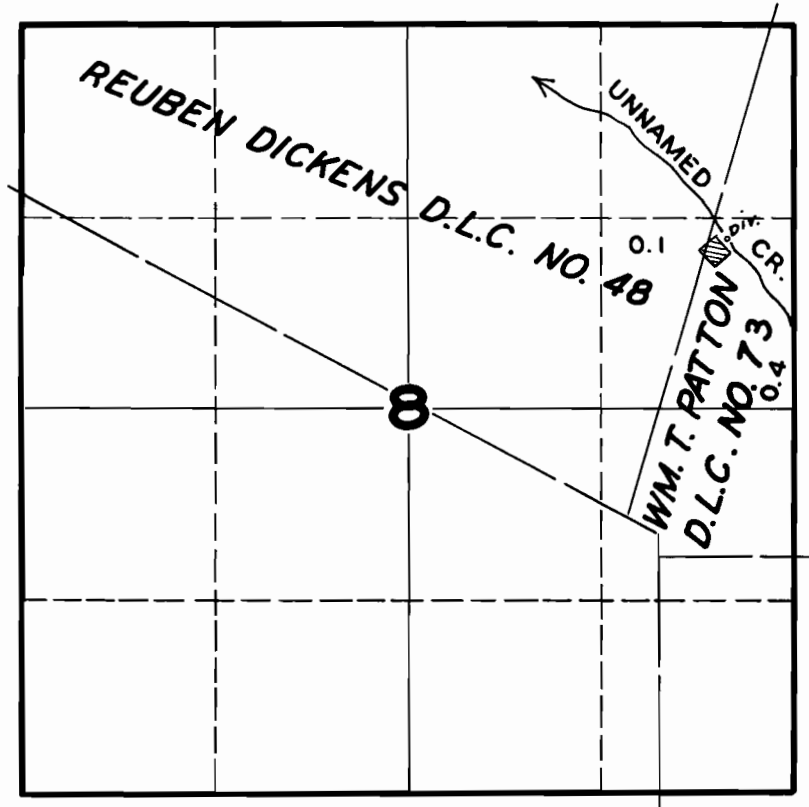

FINAL PROOF SURVEY UNDER

Application No. **21109** Permit No. **16542**
IN NAME OF

EMIL HINTZ

Surveyed **APR. 1** 1949, by **JAS. E. BUNNELL**