


T.22S.R.9W.W.M.

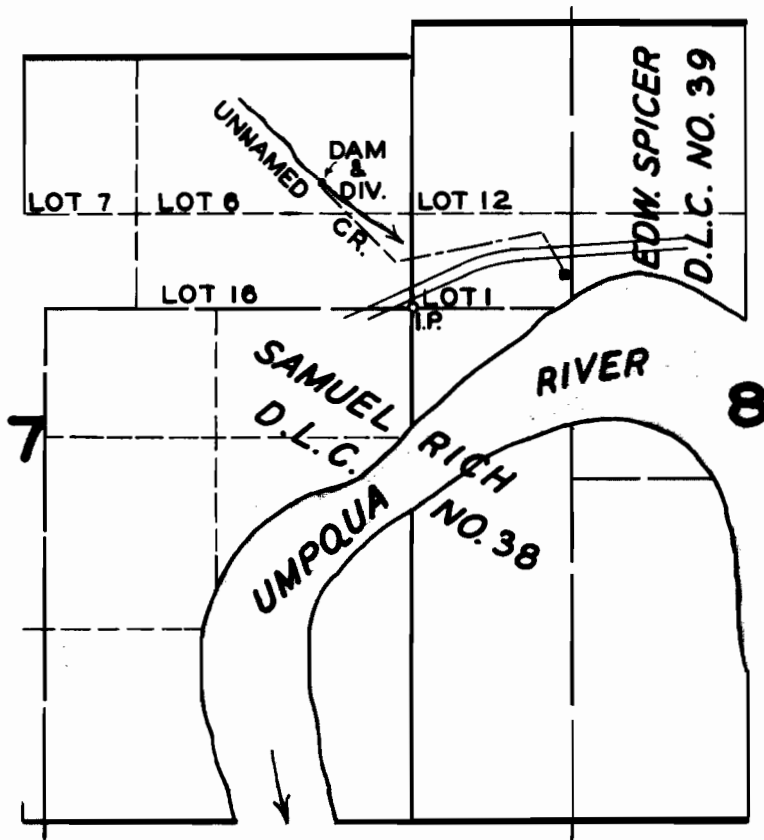

FINAL PROOF SURVEY
UNDER

Application No. 21139 Permit No. 16567
IN NAME OF

CHARLES & LENA RANDALL

Surveyed JULY 13, 1948, by JAS. E. BUNNELL