


T.16S.R.2E.W.M.

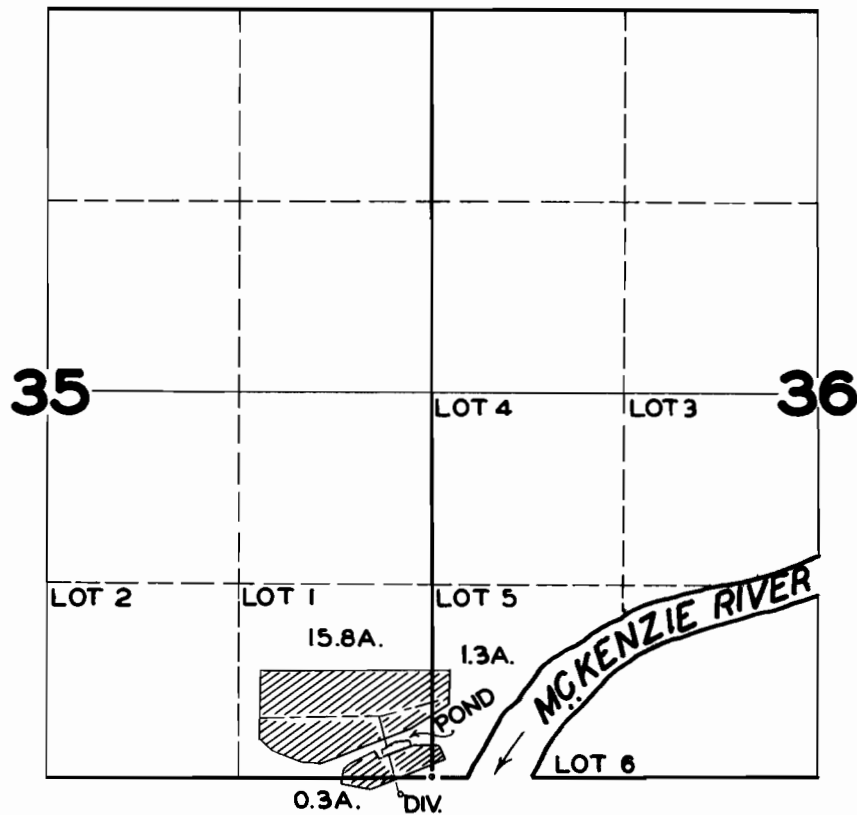

FINAL PROOF SURVEY
UNDER

Application No. **21153** ... Permit No. **16576** ...
IN NAME OF

THE BAKERS & CONFECTIONERS SUPPLY CO. OF CALIF. - W.S. HOOK, PRES.

Surveyed **JUNE 16, 1948**, by **JAS. E. BUNNELL**