


T.13&14S.R.2E.W.M.

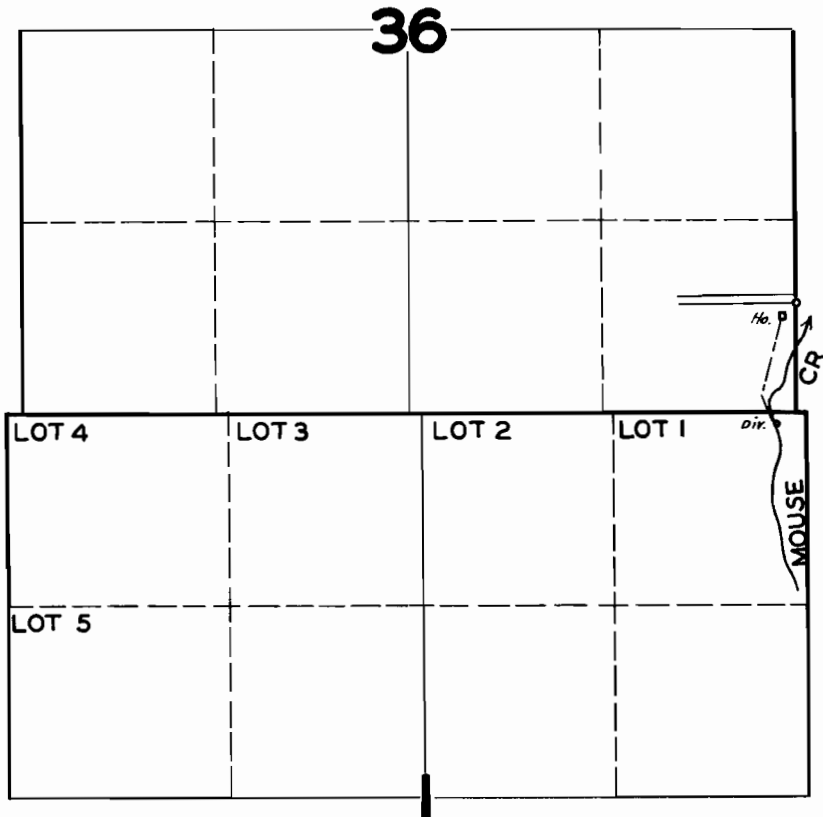

FINAL PROOF SURVEY UNDER

Application No. 21183 Permit No. 16601

IN NAME OF

E. M. HAMILTON

Surveyed OCT. 24 1947, by JAS. E. BUNNELL