


T.3N.R.39E.W.M.

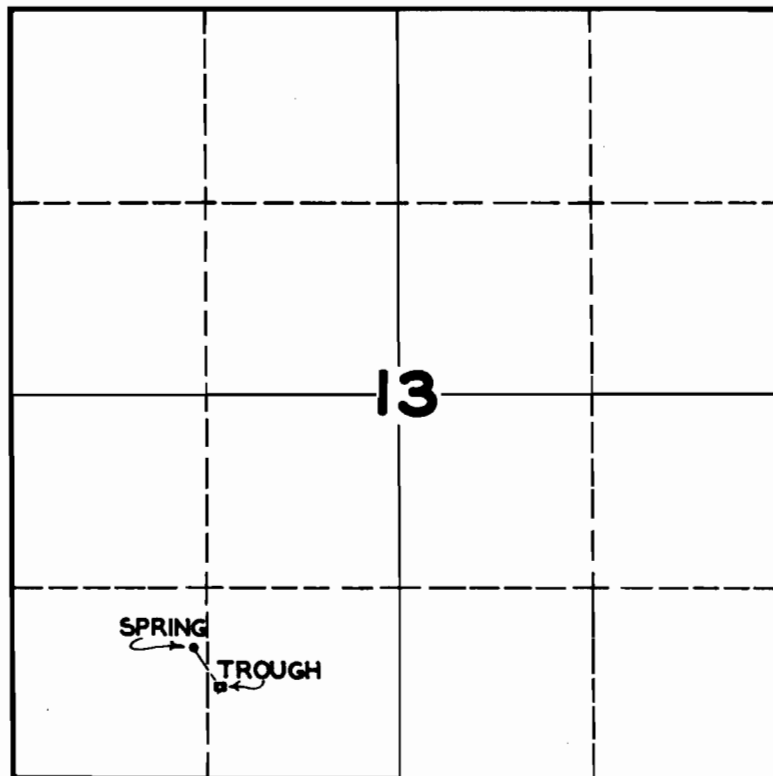

**FINAL PROOF SURVEY
UNDER**

Application No. 21192 Permit No. 16609

IN NAME OF

CECIL C. BOWMAN

Surveyed MAY 14 1947, by JAS. E. BUNNELL