


T.6S.R.IW.W.M.

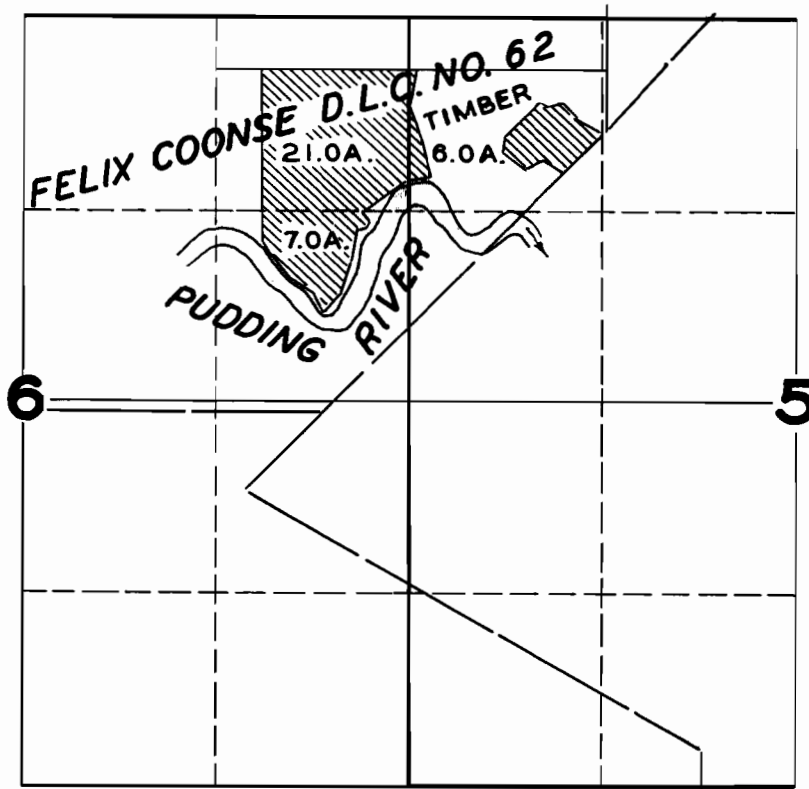

FINAL PROOF SURVEY

UNDER

Application No. 21197 Permit No. 16614

IN NAME OF

R. G. PALMER

Surveyed APR. 25 1949, by JAS. E. BUNNELL