


T.14S.R.9W.W.M.

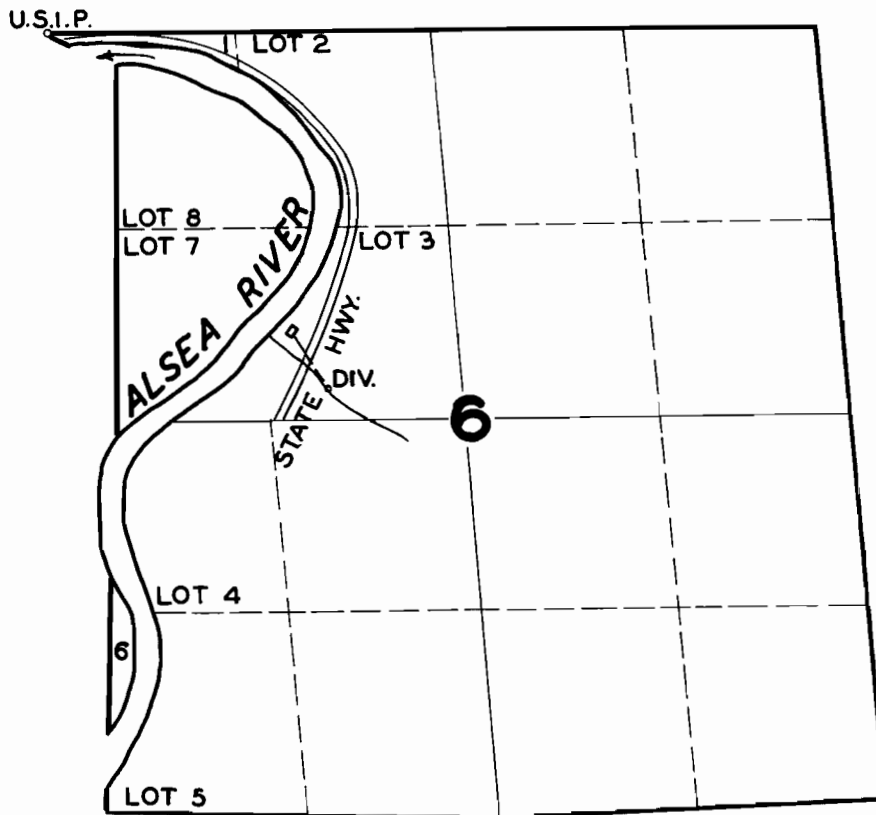

FINAL PROOF SURVEY UNDER

Application No. 21209... Permit No. 16625...
IN NAME OF

JAMES L. & EVA M. STEELE

Surveyed AUG. 4, 1948, by JAS. E. BUNNELL