


T.37S.R.14W.W.M.

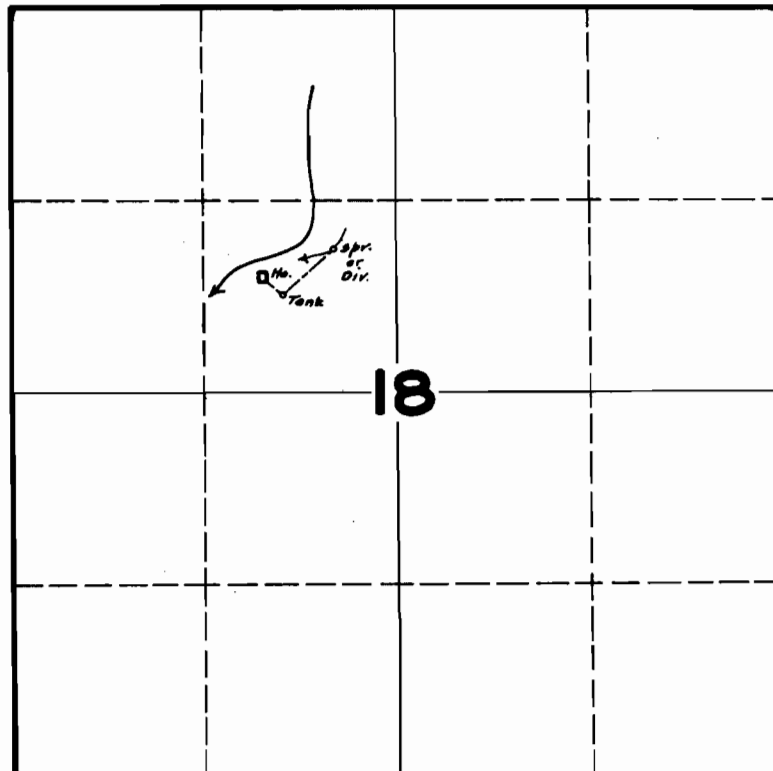

**FINAL PROOF SURVEY
UNDER**

Application No. 21226 Permit No. 16638

IN NAME OF

LINDLEY W. TAYLOR & FREIDA L. TAYLOR

Surveyed JUL. 22 1947, by JAS. E. BUNNELL