T. 28 S. R. 13 W. W. M.

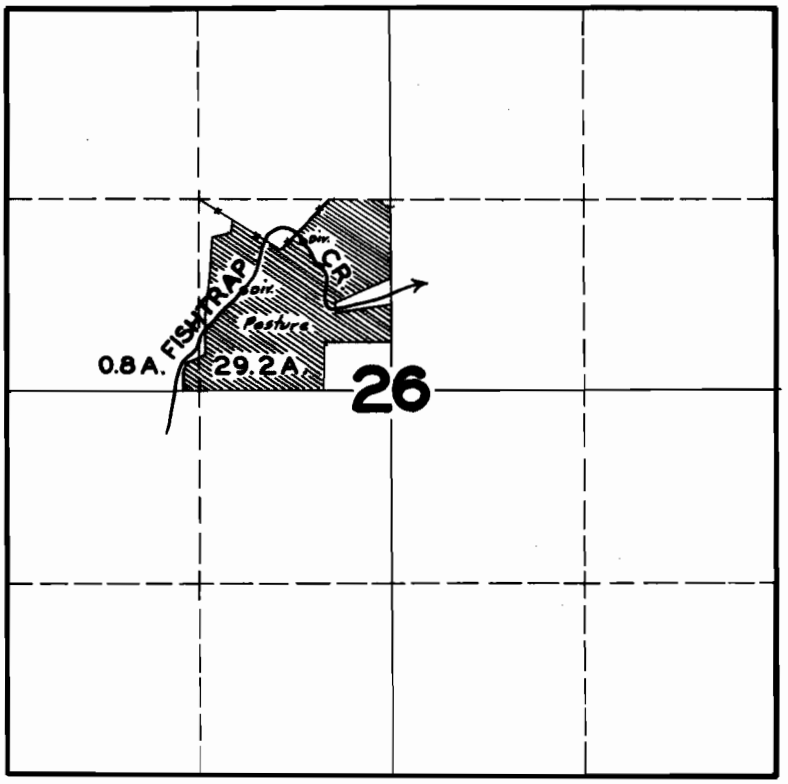

FINAL PROOF SURVEY

UNDER

Application No. 21231 Permit No. 16640

IN NAME OF

WOODROW ROBISON

Surveyed AUG. 21 1947, by JAS. E. BUNNELL

1947—D