


**T.41S.R.13W.W.M.**

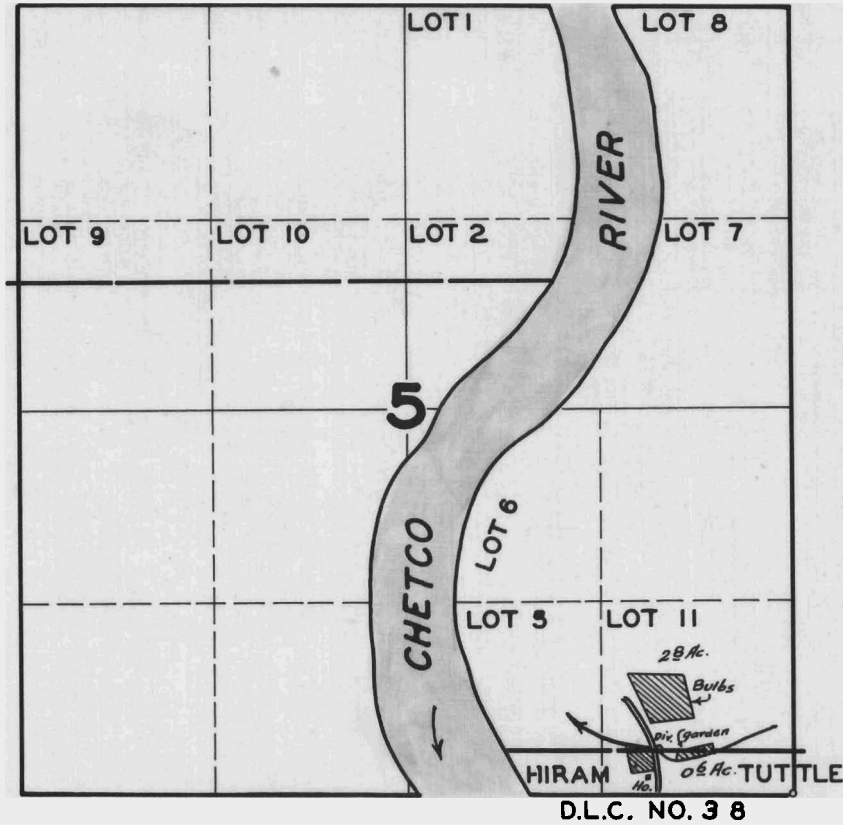

**FINAL PROOF SURVEY  
UNDER**

**Application No. 21239 Permit No. 16646**

**IN NAME OF**

**CLARENCE P. STOLLER**

**Surveyed JUL. 21, 1947, by JAS. E. BUNNELL**