


T.28S.R.12W.W.M.

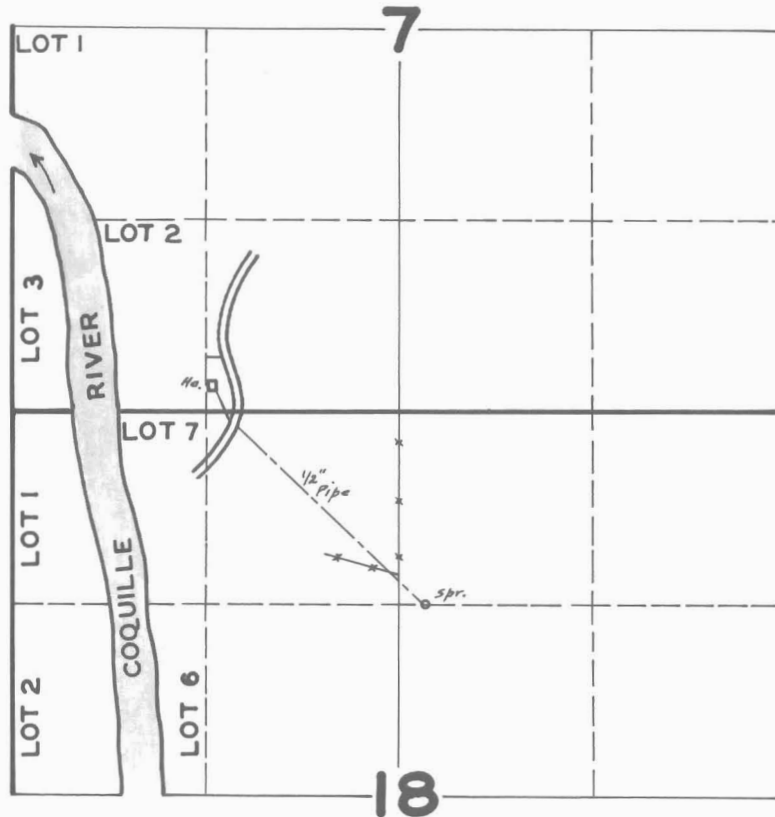

FINAL PROOF SURVEY
UNDER

Application No. 21241 Permit No. 16648

IN NAME OF

I.C. CAUDILL & ALICE V. CAUDILL

Surveyed AUG. 21 1947, by JAS. E. BUNNELL