


T.I.S.R.I.E.W.M.

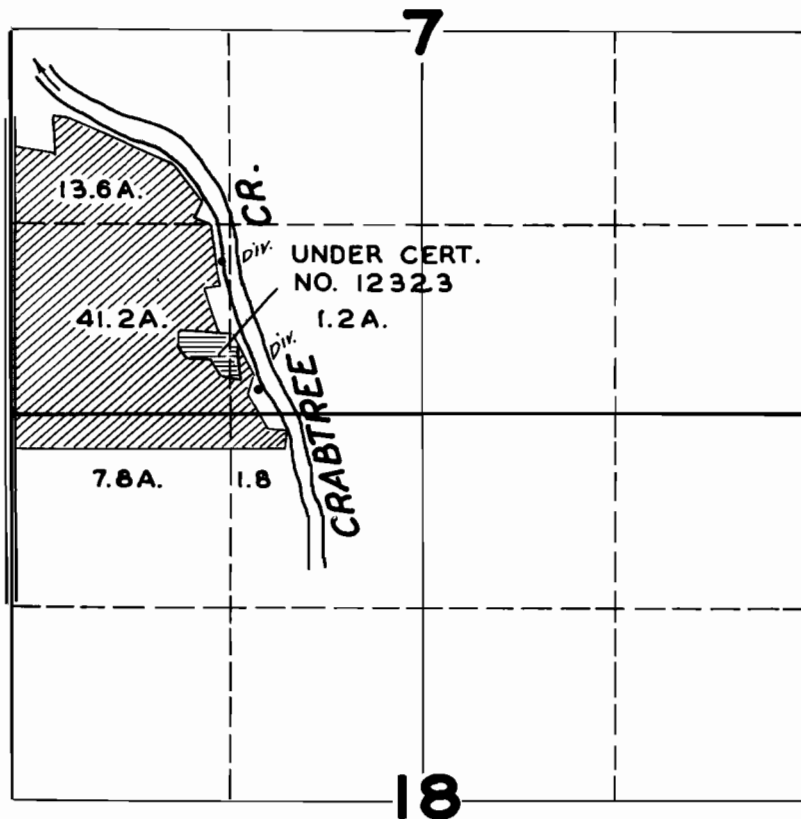

FINAL PROOF SURVEY

UNDER

Application No. 21247 Permit No. 16652

IN NAME OF

BRYCE BARTRUFF

Surveyed APR. 4 1949, by JAS. E. BUNNELL