


T.29S.R.IIW.W.M.

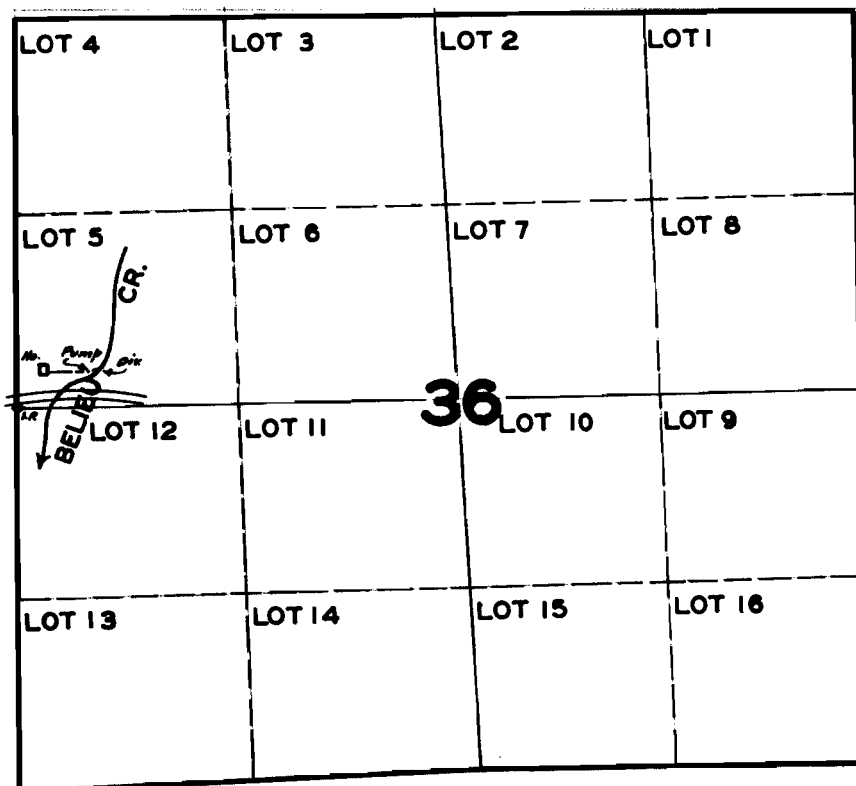

FINAL PROOF SURVEY

UNDER

Application No. 21219 Permit No. 16684

IN NAME OF

L.D. WRENTMORE

Surveyed AUG. 19, 1947, by JAS. E. BUNNELL