


T.14S.R.1E.W.M.

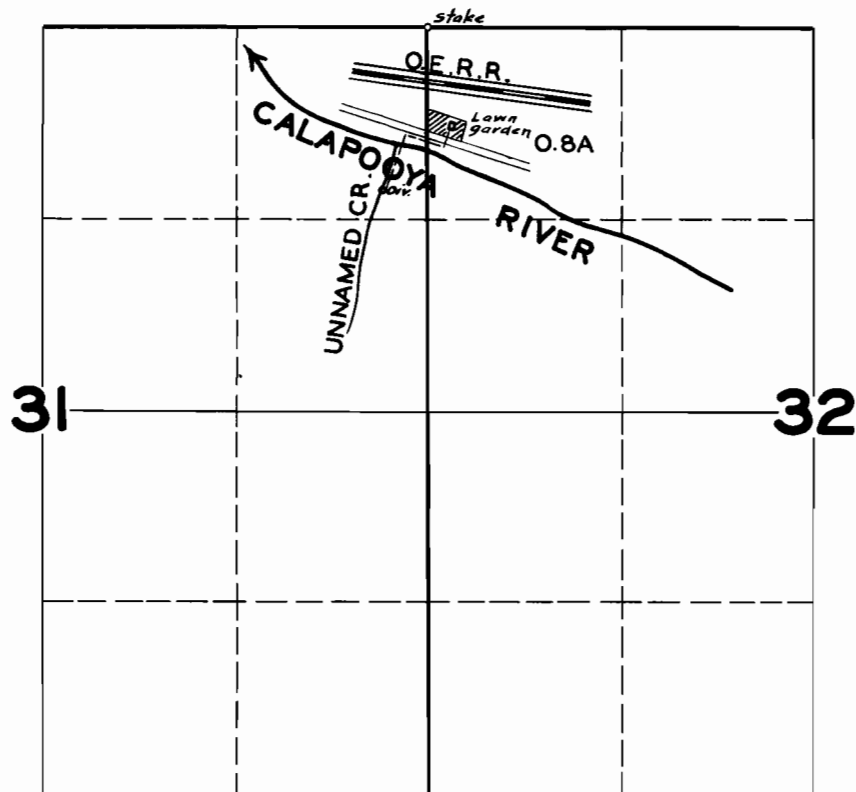

**FINAL PROOF SURVEY
UNDER**

Application No. 21302 Permit No. 16705

IN NAME OF

GAIL & AGNES CASWELL

Surveyed MAY 7, 1947, by JAS. E. BUNNELL