


# T.6S.R.1E.W.M.

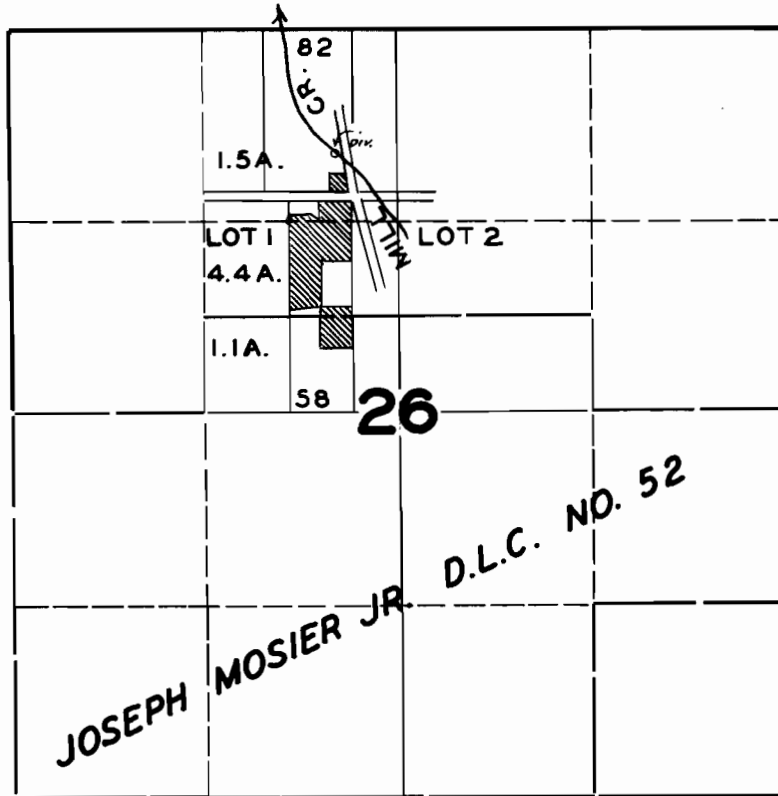

## FINAL PROOF SURVEY UNDER

Application No. 21314... Permit No. 16715...  
IN NAME OF

R. A. LAWRENCE

Surveyed JUL. 30. 1947, by JAS. E. BUNNELL