


T.6S.R.IW.W.M.

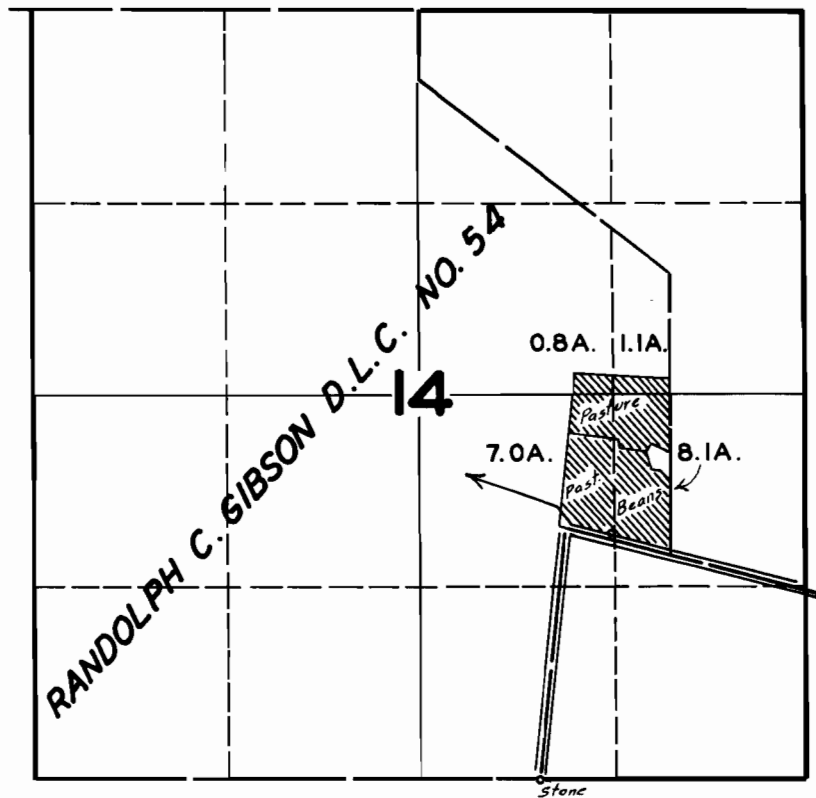

FINAL PROOF SURVEY

UNDER

• DIV.

Application No. **21351** Permit No. **16786**

IN NAME OF

JOE HAMEL

Surveyed **APR. 30**, 1947, by **JAS. E. BUNNELL**