


T.17S.R.3W.W.M.

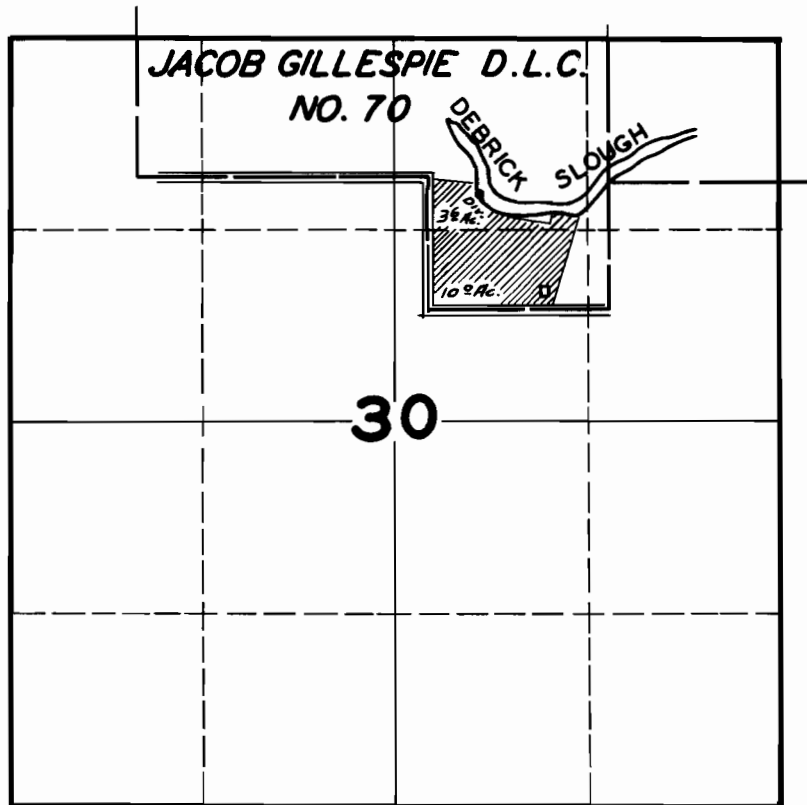

FINAL PROOF SURVEY

UNDER

Application No. 21424 Permit No. 16807

IN NAME OF

WE, JOE GRECO & TERESA GRECO - HUSBAND & WIFE

Surveyed AUG. 5, 1947, by JAS. E. BUNNELL