


T.3S.R.1W.W.M.

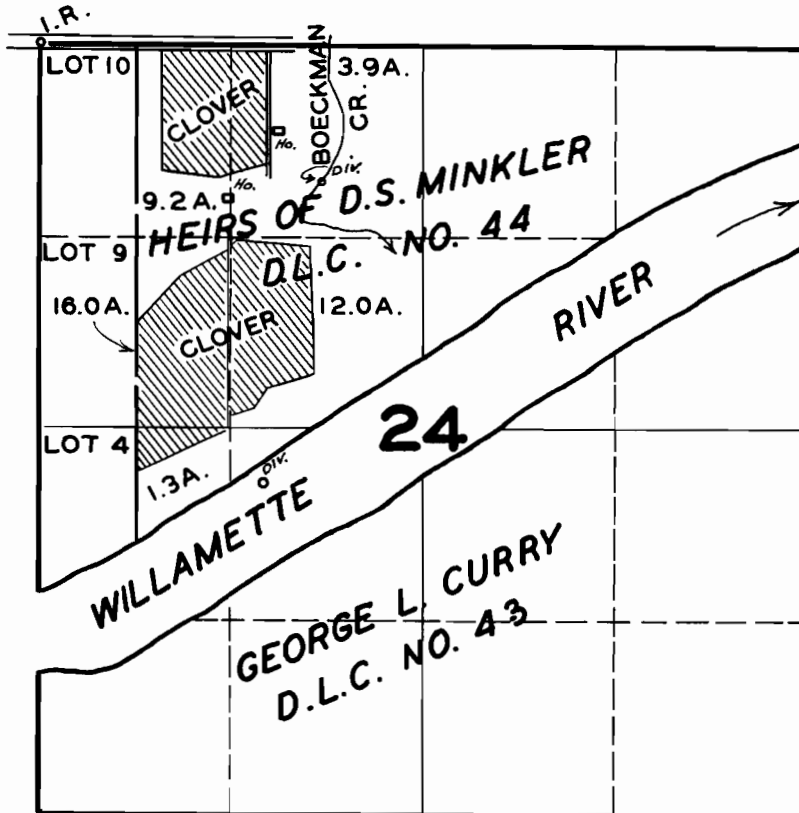

FINAL PROOF SURVEY UNDER

Application No. 21476 Permit No. 16845
IN NAME OF

CHARLES C. BOOZIER

Surveyed SEP. 3 1948, by JAS. E. BUNNELL