


T. 19S. R. 1W. W.M.

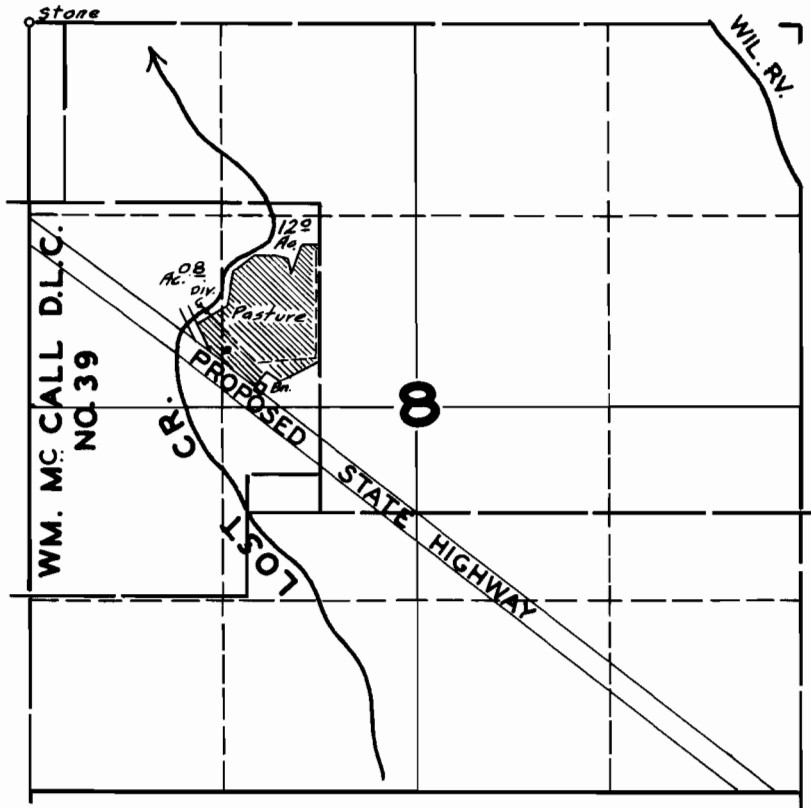

FINAL PROOF SURVEY UNDER

Application No. 21262 Permit No. 16915

IN NAME OF

D. B. & MARY C. APPLING

Surveyed AUG. 6, 1947, by JAS. E. BUNNELL