


# T.4S.R.3E.W.M.

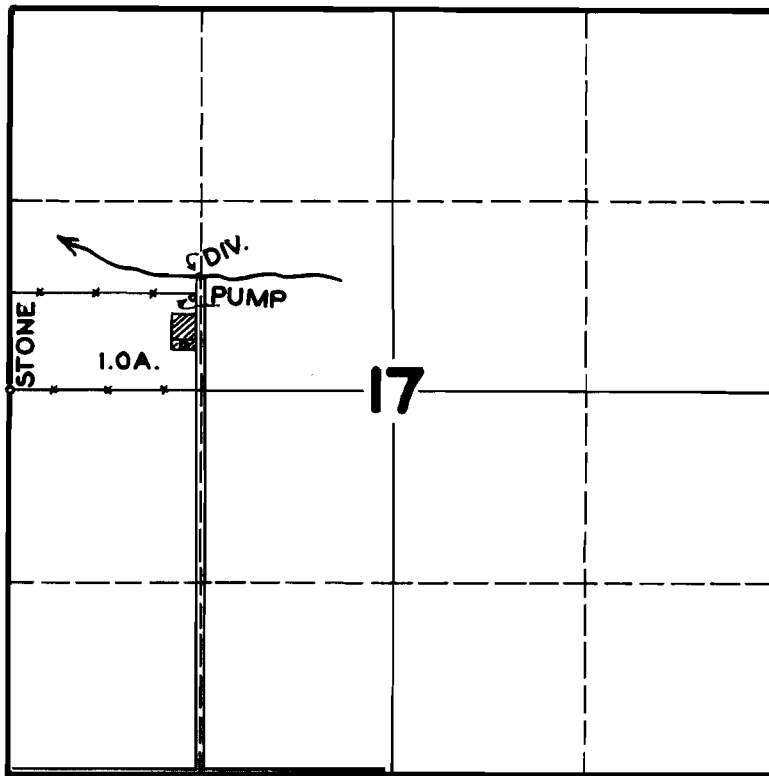

## FINAL PROOF SURVEY

UNDER

Application No. 21432 Permit No. 16917

IN NAME OF

J. J. ADKINS

Surveyed AUG. 6 1948, by JAS. E. BUNNELL