


# T.7S.R.1W.W.M.

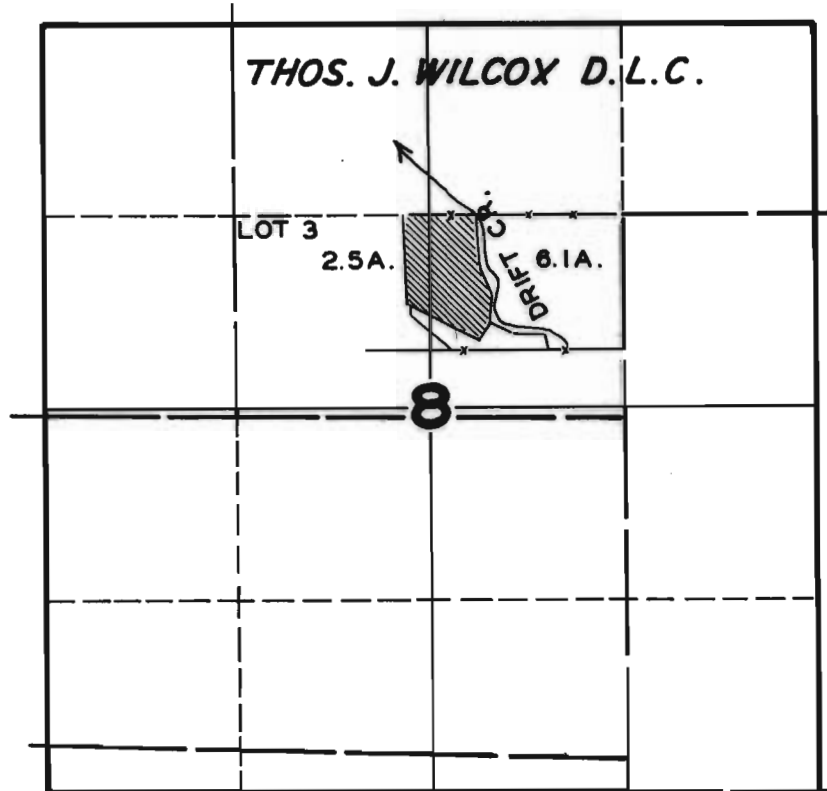

## FINAL PROOF SURVEY UNDER

Application No. 21517..... Permit No. 16933.....  
IN NAME OF

**CARL SCHMID**

Surveyed OCT. 25 1947, by JAS. E. BUNNELL